

TERRY SCHMIDTBAUER
Director (Interim)

ALLAN CALDER
Planning Services Manager

DEPARTMENT OF RESOURCE MANAGEMENT



**SOLANO
COUNTY**

675 Texas Street, Suite 5500
Fairfield, CA 94533-6342
(707) 784-6765
Fax (707) 784-4805

www.solanocounty.com

Planning Services Division

SOLANO COUNTY ZONING ADMINISTRATOR

**Staff Report
SGN-20-05**

Application No. SGN-20-05 (Oday Road 76) Project Planner: Travis Kroger, Assistant Planner		Meeting of September 2, 2021 Agenda Item No. 1	
Applicant Sign Designs Inc Steve Locke 204 Campus Way Modesto, CA 95350		Property Owner Mahmoud Ali Karaouni 7335 Oday Rd . Vacaville CA 95688	
Action Requested Consideration of Sign Permit SGN-20-05 to permit signage for a new 76 service station to include canopy logos and LED light bars, a monument price sign, replacement faces for the tall freeway sign, a wall mounted sign for the convenience store, and the as-built center identification sign, and wall mounted signs for the produce market as required by Policy Plan Overlay PP-02-04, APN 0109-170-220. No other changes to the site or new development are proposed.			
Property Information			
Size: 6.47 ac. (total)		Location: 7335 Oday Road	
APN: 0109-170-220			
Zoning: Highway Commercial (CH)		Land Use: Sign	
General Plan: Highway Commercial		Ag. Contract: n/a	
Utilities: private well and septic system		Access: Oday Road	
Adjacent General Plan Designation, Zoning District, and Existing Land Use			
	General Plan	Zoning	Land Use
North	Rural Residential	Rural Residential (RR-2.5)	Residential
South	Incorporated Area	Incorporated Area	Vacant/Highway
East	Agriculture	Exclusive Agriculture (A-40)	Commercial Agriculture
West	Rural Residential	Rural Residential (RR-2.5)	Residential
Environmental Analysis The project qualifies for a Class I Categorical Exemption from the California Environmental Quality Act pursuant to CEQA Guidelines Section 15301, Existing Facilities.			

Motion to Approve

The Zoning Administrator does hereby ADOPT the attached resolution and APPROVE Sign Permit SGN-20-05 based on the enumerated findings and subject to the recommended conditions of approval.

PROJECT DESCRIPTION

The applicant has applied for a Master Sign Permit to permit the existing center identification sign, tall freeway sign and wall mounted signage for the existing produce stand and permit signage for the new 76 service station currently under construction. The signage proposed is listed below, which meets the maximum number and square feet of signs permitted by the Master Sign Plan regulations in Section 28.96 of the Solano County Code and as allowed by Policy Plan Overlay PP-02-04.

Type	Number	Size (Sq. Ft.)
Price Sign	1	84
Tall freeway sign	1	40
Center ID sign	1	~84
"Open" signs	2	n/a
"Produce" wall mount sign	1	15
Illuminated canopy logos	2	10.5
LED light bar	1	155
Convenience Store sign	1	50
"Olive Tree Farm & Market" wall mount sign	1	30



LAND USE CONSISTENCY

The parcel is designated Highway Commercial by the Solano County General Plan Land Use Diagram. As indicated on the General Plan land use consistency table (General Plan Table LU-7) the Highway Commercial (CH) Zoning District is consistent with this designation.

The subject site is zoned Highway Commercial (CH). Within this district, a master sign up to 6 signs are allowed with a total area of 400 square feet subject to Section 28.96 of the Solano County Code. These general requirements include standards for height, size, lighting and location of signs.

ENVIRONMENTAL ANALYSIS

The project qualifies for a Class I Categorical Exemption from the California Environmental Quality Act pursuant to CEQA Guidelines Section 15301, Existing Facilities.

RECOMMENDATION

Staff recommends that the Zoning Administrator **ADOPT** the mandatory and suggested findings, and **APPROVE** SGN-20-05, subject to the recommended conditions of approval.

MASTER SIGN PLAN MANDATORY FINDINGS

- 1. The proposed signage does not exceed the standards of Sections 28.96.060 (Zoning District Sign Standards) and 28.96.070 (Standards for Specific Types of Signs), and is of the minimum size and height necessary to enable motorists and pedestrian to readily identify the facility or site from a sufficient distance to safely and conveniently access the facility or site.**

Within the Highway Commercial (CH) zoning district, freestanding and wall mount are allowed sign types. Signage is limited to a maximum 200 square feet, or up to 400 square feet with approval of a Master Sign Plan. Freestanding signs are limited to a maximum of 6 feet tall except for the freeway sign and center identification sign as allowed by PP-02-04. The applicant has applied for a Sign Permit to permit existing as-built signage and new signage for a 76 station and convenience store as detailed above.

The freestanding price sign will be installed to the right of the driveway when entering the property from Oday Road. The signage will alert customers and employees of the business from a sufficient distance to safely and conveniently access the site.

- 2. The size, location, and design of the sign are visually complementary and compatible with the size and architectural style of the primary structures on the site, any prominent natural features of the site, and structures and prominent natural features on adjacent properties on the same street in the immediate vicinity.**

The proposed signage is complementary and compatible with the character of the existing site.

- 3. The proposed sign is in substantial conformance with the sign design criteria provided in Section 28.96.050 (D) and (E) of the Sign Regulations.**

The proposed signs meet the pertinent standards regarding design and illumination as set forth in Sections 28.96.050 (D) and (E) of the Solano County Zoning Ordinance.

ADDITIONAL FINDINGS

1. The project qualifies for a Class I Categorical Exemption from the California Environmental Quality Act pursuant to CEQA Guidelines Section 15301, Existing Facilities.

RECOMMENDATION

Department staff recommends that the Zoning Administrator **ADOPT** the mandatory findings, and **APPROVE** Sign Permit application SGN-20-05, based on the findings enumerated herein, and subject to the conditions of approval incorporated in this report.

CONDITIONS OF APPROVAL

General

1. All signage shall be established in accord with the application materials submitted with Sign Permit application SGN-20-05 filed October 28, 2020 (and revised plans submitted May 3, 2021 and as approved by the Solano County Zoning Administrator.
2. Any expansion or change in the project; including size, type, or location of signage may require application for a new or revised sign permit.
3. The permittee shall remain in compliance with the Sign Regulations as set forth in Section 28.96 of the Solano County Zoning Ordinance.
4. Any business located on the site will maintain a current Solano County Business License.
5. The approval of any illuminated sign shall not be final until thirty (30) days after installation during which time the Director of Resource Management may order dimming if the illumination is found to be excessively brilliant. Sign illumination shall be considered excessive when it prevents the normal perception of objects or buildings beyond or in the vicinity of the sign or impacts nearby residentially developed or zoned properties.

Building and Safety Division

6. Prior to any construction or improvements taking place, a Building Permit Application shall first be submitted as per the 2019 California Building Code, or the most current edition of the code enforced at the time of the building permit application. "Any owner or authorized agent who intends to construct signs taller than 6 feet or installation of electrical system shall first make application to the building official and obtain the required permit.

Public Works Division

7. The monument sign at the Oday Road driveway shall not obstruct the sight distance for vehicles entering Oday Road from the property's driveway access. The sight distance from the property access shall be maintained in accordance with Section 405.1 "Corner Sight Distance" of the latest

Caltrans Highway Design Manual.

Environmental Health Division

8. No Conditions

Attachments

A – Draft Resolution

B – Assessor’s Parcel Map

**SOLANO COUNTY ZONING ADMINISTRATOR
RESOLUTION NO. XX-XX**

WHEREAS, the Solano County Zoning Administrator has considered Sign Permit SGN-20-05 to permit signage for a new 76 service station to include canopy logos and LED light bars, a monument price sign, replacement faces for the tall freeway sign, a wall mounted sign for the convenience store, and the as-built center identification sign, and wall mounted signs for the produce market as required by Policy Plan Overlay PP-02-04, APN 0109-170-220; and

WHEREAS, said Zoning Administrator has reviewed the report of the Department of Resource Management and heard testimony relative to the subject application at the duly noticed public hearing held on September 2, 2021; and

WHEREAS, after due consideration, the Zoning Administrator has made the following findings in regard to said proposal:

- 1. The proposed signage does not exceed the standards of Sections 28.96.060 (Zoning District Sign Standards) and 28.96.070 (Standards for Specific Types of Signs), and is of the minimum size and height necessary to enable motorists and pedestrian to readily identify the facility or site from a sufficient distance to safely and conveniently access the facility or site.**

Within the Highway Commercial (CH) zoning district, freestanding and wall mount are allowed sign types. Signage is limited to a maximum 200 square feet, or up to 400 square feet with approval of a Master Sign Plan. Freestanding signs are limited to a maximum of 6 feet tall except for the freeway sign and center identification sign as allowed by PP-02-04. The applicant has applied for a Sign Permit to permit existing as-built signage and new signage for a 76 station and convenience store as detailed above.

The freestanding price sign will be installed to the right of the driveway when entering the property from Oday Road. The signage will alert customers and employees of the business from a sufficient distance to safely and conveniently access the site.

- 2. The size, location, and design of the sign are visually complementary and compatible with the size and architectural style of the primary structures on the site, any prominent natural features of the site, and structures and prominent natural features on adjacent properties on the same street in the immediate vicinity.**

The proposed signage is complementary and compatible with the character of the existing site.

- 3. The proposed sign is in substantial conformance with the sign design criteria provided in Section 28.96.050 (D) and (E) of the Sign Regulations.**

The proposed signs meet the pertinent standards regarding design and illumination as set forth in Sections 28.96.050 (D) and (E) of the Solano County Zoning Ordinance.

4. The project qualifies for a Class I Categorical Exemption from the California Environmental Quality Act pursuant to CEQA Guidelines Section 15301, Existing Facilities.

BE IT THEREFORE RESOLVED, that the Zoning Administrator has approved Sign Permit SGN-20-05 subject to the following recommended conditions of approval:

General

1. All signage shall be established in accord with the application materials submitted with Sign Permit application SGN-20-05 filed October 28, 2020 (and revised plans submitted May 3, 2021 and as approved by the Solano County Zoning Administrator.
2. Any expansion or change in the project; including size, type, or location of signage may require application for a new or revised sign permit.
3. The permittee shall remain in compliance with the Sign Regulations as set forth in Section 28.96 of the Solano County Zoning Ordinance.
4. Any business located on the site will maintain a current Solano County Business License.
5. The approval of any illuminated sign shall not be final until thirty (30) days after installation during which time the Director of Resource Management may order dimming if the illumination is found to be excessively brilliant. Sign illumination shall be considered excessive when it prevents the normal perception of objects or buildings beyond or in the vicinity of the sign or impacts nearby residentially developed or zoned properties.

Building and Safety Division

6. Prior to any construction or improvements taking place, a Building Permit Application shall first be submitted as per the 2019 California Building Code, or the most current edition of the code enforced at the time of the building permit application. "Any owner or authorized agent who intends to construct signs taller than 6 feet or installation of electrical system shall first make application to the building official and obtain the required permit.

Public Works Division

7. The monument sign at the Oday Road driveway shall not obstruct the sight distance for vehicles entering Oday Road from the property's driveway access. The sight distance from the property access shall be maintained in accordance with Section 405.1 "Corner Sight Distance" of the latest Caltrans Highway Design Manual.


Environmental Health Division

8. No Conditions.

* * * * *

I hereby certify that the foregoing resolution was adopted at the regular meeting of the Solano County Zoning Administrator on September 2, 2021.

Allan M. Calder, Planning Manager
Resource Management

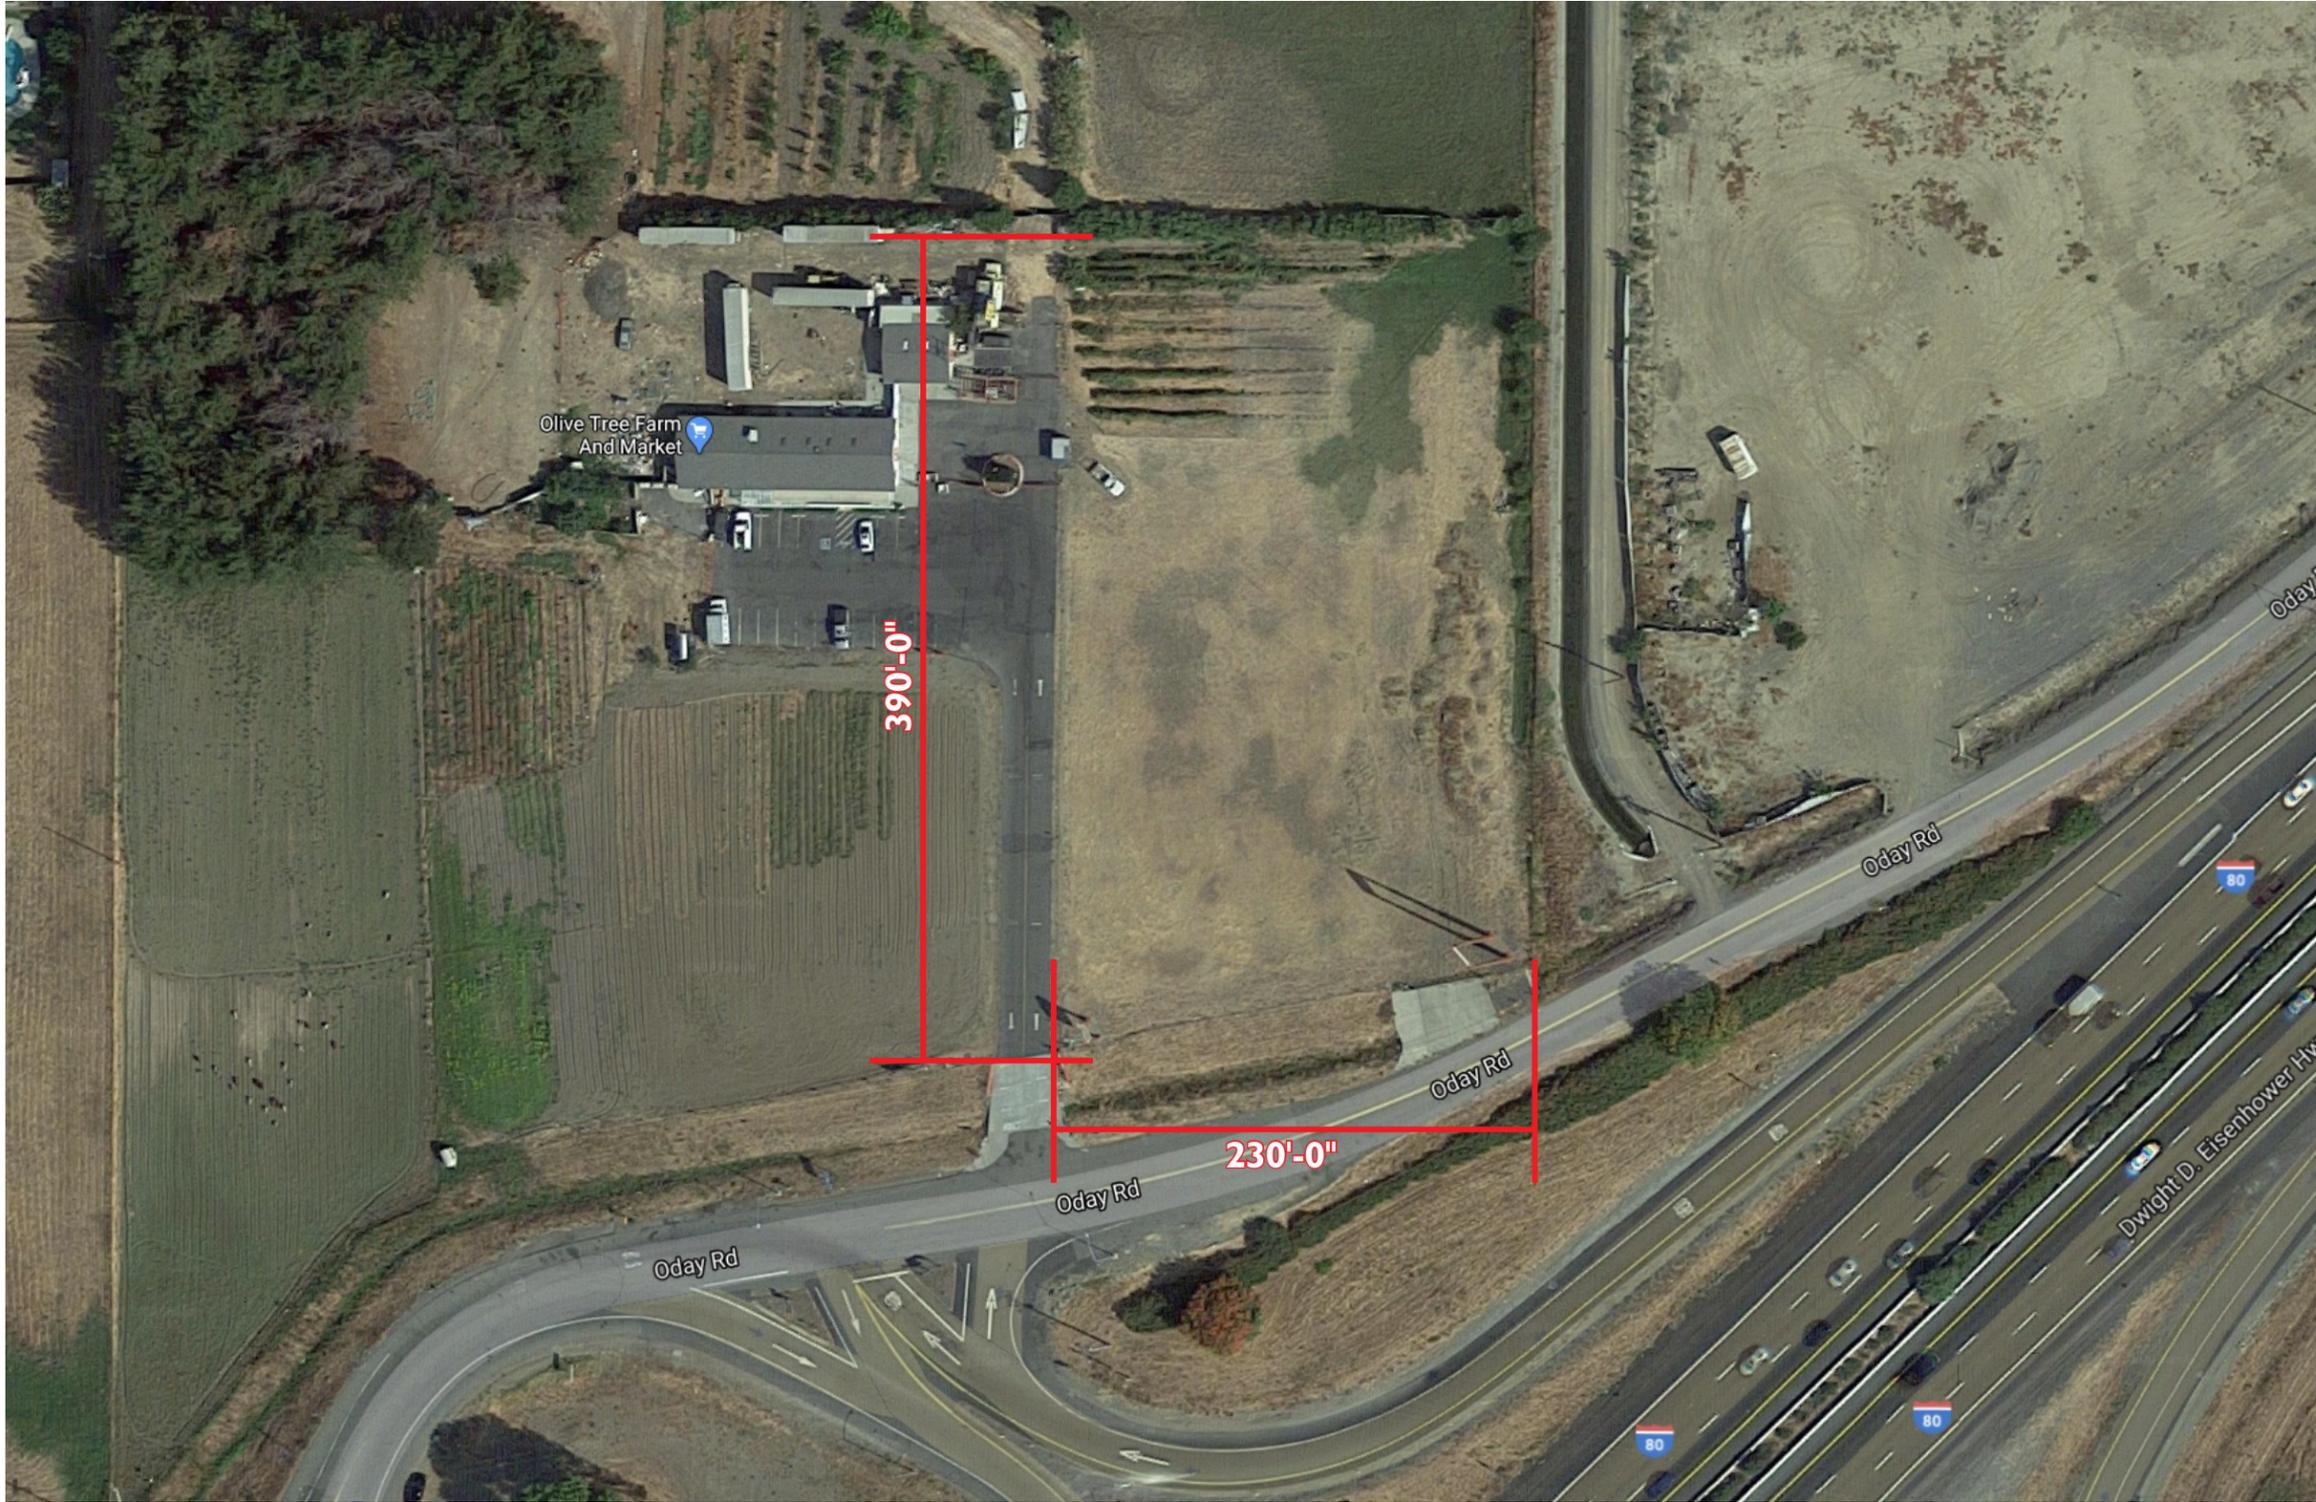

05.05.21 R19 VT: REVERT ILLUMINATION TO GOOSENECK LAMPS FOR SIGNS A, D & K. REVERT SIGN C TO R15 VERSION, ALL PER JEFF STOCKTON, NO OTHER CHANGES. 04.18.21 R18 VT: CHANGE SIGN D TO 12X5; ADD "REMOVED BY OTHERS" TO SIGN C, CABINET PER JEFF STOCKTON, NO OTHER CHANGES. 04.13.21 R17 VT: CHANGE SIGN D TO 6X5; CABINET PER JEFF STOCKTON, NO OTHER CHANGES. 02.18.21 R16 VT: REMOVE ALL GOOSENECK LAMPS AND REVERT TO LEDS, REVERT SIGN C TO OLD MONUMENT FROM R2, ALL PER JEFF STOCKTON, NO OTHER CHANGES. 01.19.21 R15 VT: REVERT CANOPY SIGNS A PER JEFF STOCKTON, NO OTHER CHANGES. 01.19.21 R14 VT: REMOVE "X" FROM TWIN POLE SIGN ON PHOTO (PG 12) PER STEVE LOCKE, NO OTHER CHANGES. 01.14.21 R13 VT: UPDATE ADDRESS AND UPDATE SIGN L TO 7337, PER JEFF STOCKTON, NO OTHER CHANGES. 01.12.21 R12 VT: VARIOUS REDLINE CHANGES PER STEVE LOCKE, JEFF STOCKTON, ADD SIGN L (PVC ADDRESS NUMERALS), REVISE SIGN K TO "STARS" CONVENIENCE STORE PER JEFF STOCKTON/CUSTOMER, NO OTHER CHANGES. 12.23.20 R10 VT: ADD GOOSENECK LAMPS TO SIGNS A,D & K, REPLACE SIGN C WITH NEW MONUMENT SIGN, ADD VARIOUS MEASUREMENTS TO EXISTING SIGN PHOTOS ALL PER JEFF STOCKTON, NO OTHER CHANGES. 10.19.20 R10 VT: MARK POLE SIGNS ARE "REMOVED" ON PG 11 PER STEVE LOCKE, NO OTHER CHANGES. 09.03.20 R9 VT: REVISE SIGN C NEW POLE & FOOTING PER JEFF STOCKTON, NO OTHER CHANGES. 08.24.20 R1 VT: ADD PHOTOS OF EXISTING SIGNS TO BE REMOVED PER JEFF STOCKTON, NO OTHER CHANGES. 08.12.20 R7 VT: CHANGE SIGN C OAH TO 19'-6" PER JEFF STOCKTON, NO OTHER CHANGES. 08.07.20 R6 VT: ADD VARIOUS MEASUREMENTS, UPDATE SIGN C MOUNTING DETAIL, ADD STAMPED ENGINEERING PAGE, ALL PER JEFF STOCKTON, NO OTHER CHANGES. 08.06.20 R5 VT: UPDATE SITE MAP PER JEFF STOCKTON, NO OTHER CHANGES. 07.28.20 R4 VT: SIGN D-SWAP DIESEL #2 AND 24 HOURS FACES, SIGN K- SWAP COLOR SCHEME ON BACKER PANEL PER JEFF STOCKTON/CUSTOMER, NO OTHER CHANGES. 07.10.20 R3 VT: REMOVE SIGN L, CHANGE SIGN K TO "A CONVENIENCE STORE" PANS ON BACKER, ADD MOUNTING DETAILS TO SIGN D, CHANGE SIGN C LEDS TO WHITE, ALL PER JEFF STOCKTON, NO OTHER CHANGES. 06.02.20 R2 VT: PUT SIGN C ON POLE, SHOW SIGN D AS HORIZ LAYOUT AND WRONG PROPORTIONS PER JEFF STOCKTON, UPDATE PHOTO FOR SIGN K/L, ALL PER JEFF STOCKTON, NO OTHER CHANGES. 05.26.20 R1 VT: REVISE SIGN D OAH SIZE TO 8' X 5'; ADD SIGNS K & L, ALL PER JEFF STOCKTON, NO OTHER CHANGES.

PERMIT DRAWING

200337 R19 / 1 OF 13

PO Box 4590 | 204 Campus Way Modesto Ca 95350 | O 209.524.4484 | F 209.521.0272 | Ca LIC#268001 | C-45 | Nv Lic#0082570 | C-6

MEMBER

NOTICE TO THE CUSTOMER

Note: The colors depicted on this rendering may not match actual colors used on the finished display. Please refer to the detail drawing for the approved color specifications. Note: The cost of providing electrical wiring to the sign area, all required permits and all special inspections are not included in this sign proposal. Note: The proportion of signs shown on building & landscape area photos is an approximate representation.

CUSTOMER APPROVAL

ACCEPTED W/ NO CHANGES ACCEPTED W/ CHANGES AS NOTED
 REVISE AS NOTED AND RESUBMIT

BY CUSTOMER BY LANDLORD
DATE _____ DATE _____

DATE	BY	DATE	BY
05.05.20	VT	12.23.20	VT
05.26.20	VT	01.12.21	VT
06.02.20	VT	01.14.21	VT
07.10.20	VT	01.19.21	VT
07.28.20	VT	01.19.21	VT
08.06.20	VT	02.18.21	VT
08.07.20	VT	04.13.21	VT
08.24.20	VT	04.18.21	VT
09.03.20	VT	05.05.21	VT
10.19.20	VT		

COMPANY OR JOB NAME / JOB DESCRIPTION **200337 R19**

76 SIGN PROGRAM

ADDRESS: **7337 ODAY ROAD VACAVILLE CALIFORNIA 95688**

SALESPERSON: **JEFF STOCKTON** CUSTOMER CONTACT: **XXXXXX**

© 2021


This drawing was created to assist you in visualizing our proposal. The original ideas herein are the property of Sign Designs. Permission to copy or revise this drawing can only be obtained thru a written agreement w/ Sign Designs. See your sales representative or call Sign Designs.

By signing this drawing document, I understand that I am not obligated to purchase this project, notwithstanding, the above artwork cannot be submitted for pricing, duplication and/or manufacturing to another sign company, architectural company or other business entity for the purpose or intent of manufacturing or for use as intellectual property, such as, but not limited to, a company logo, unless the represented logo was provided to Sign Designs by the customer and input into this drawing document by a Sign Designs employee.

NAME / DATE **1 OF 13**

This sign is intended to be installed in accordance with the requirements of ARTICLE 600 of the national electrical code &/or other applicable codes. this includes proper grounding & bonding of the sign. The location of the disconnect switch after installation shall comply w/ ARTICLE 600.6(A)(1) of the National Electrical Code. All measures shown in this drawing are nominal until the "NOT FOR PRODUCTION" is removed

PERMIT DRAWING

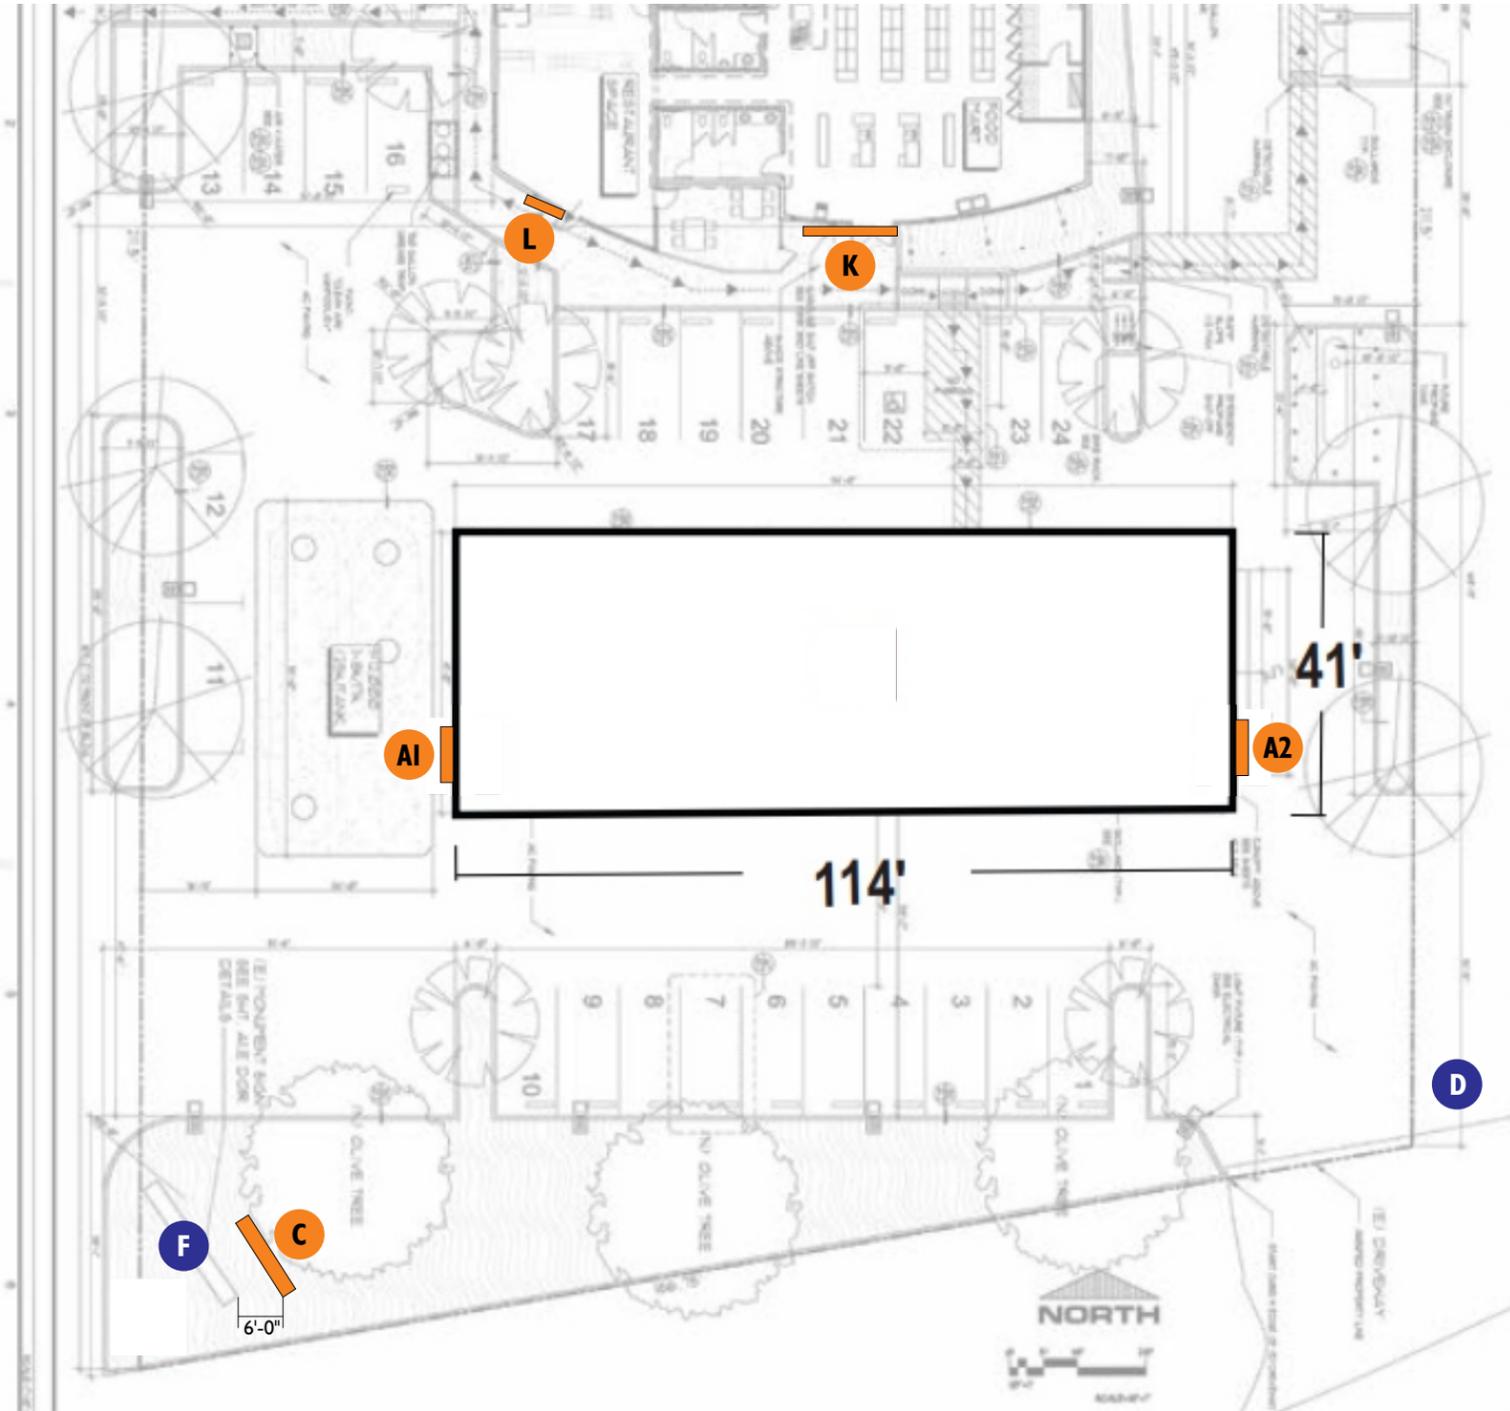

05.05.21 R19 VT: REVERT ILLUMINATION TO GOOSENECK LAMPS FOR SIGNS A, D & K. REVERT SIGN C TO R15 VERSION, ALL PER JEFF STOCKTON, NO OTHER CHANGES. 04.18.21 R18 VT: CHANGE SIGN D TO 12X5; ADD "REMOVED BY OTHERS" TO SIGN C, CABINET PER JEFF STOCKTON, NO OTHER CHANGES. 04.13.21 R17 VT: CHANGE SIGN D TO 6X5; CABINET PER JEFF STOCKTON, NO OTHER CHANGES. 02.18.21 R16 VT: REMOVE ALL GOOSENECK LAMPS AND REVERT TO LEDS; REVERT SIGN C TO OLD MONUMENT FROM R2. ALL PER JEFF STOCKTON, NO OTHER CHANGES. 01.19.21 R15 VT: REVERT CANOPY SIGNS A PER JEFF STOCKTON, NO OTHER CHANGES. 01.19.21 R14 VT: REMOVE "X" FROM TWIN POLE SIGN ON PHOTO (PG 12) PER STEVE LOCKE, NO OTHER CHANGES. 01.14.21 R13 VT: UPDATE ADDRESS AND UPDATE SIGN L TO 7337. PER JEFF STOCKTON, NO OTHER CHANGES. 01.12.21 R12 VT: VARIOUS REDLINE CHANGES PER STEVE LOCKE, JEFF STOCKTON, ADD SIGN L (PVC ADDRESS NUMERALS), REVISE SIGN K TO "STARS" CONVENIENCE STORE PER JEFF STOCKTON/CUSTOMER. 12.23.20 R10 VT: ADD GOOSENECK LAMPS TO SIGNS A, D & K, REPLACE SIGN C WITH NEW MONUMENT SIGN, ADD VARIOUS MEASUREMENTS TO EXISTING SIGN PHOTOS ALL PER JEFF STOCKTON, NO OTHER CHANGES. 10.19.20 R10 VT: MARK POLE SIGNS ARE "REMOVED" ON PG 11 PER STEVE LOCKE, NO OTHER CHANGES. 09.03.20 R9 VT: REVISE SIGN C NEW POLE & FOOTING PER JEFF STOCKTON, NO OTHER CHANGES. 08.24.20 R1 VT: ADD PHOTOS OF EXISTING SIGNS TO BE REMOVED PER JEFF STOCKTON, NO OTHER CHANGES. 08.12.20 R7 VT: CHANGE SIGN C OAH TO 19'-6" PER JEFF STOCKTON, NO OTHER CHANGES. 08.07.20 R6 VT: ADD VARIOUS MEASUREMENTS, UPDATE SIGN C MOUNTING DETAIL, ADD STAMPED ENGINEERING PAGE, ALL PER JEFF STOCKTON, NO OTHER CHANGES. 08.06.20 R5 VT: UPDATE SITE MAP PER JEFF STOCKTON, NO OTHER CHANGES. 07.28.20 R4 VT: SIGN D-SWAP DIESEL #2 AND 24 HOURS FACES, SIGN K- SWAP COLOR SCHEME ON BACKER PANEL PER JEFF STOCKTON/CUSTOMER, NO OTHER CHANGES. 07.10.20 R3 VT: REMOVE SIGN L, CHANGE SIGN K TO "A CONVENIENCE STORE" PANS ON BACKER, ADD MOUNTING DETAILS TO SIGN D, CHANGE SIGN C LEDS TO WHITE, ALL PER JEFF STOCKTON, NO OTHER CHANGES. 06.02.20 R2 VT: PUT SIGN C ON POLE, SHOW SIGN D AS HORZ LAYOUT AND WRONG PROPORTIONS PER JEFF STOCKTON, UPDATE PHOTO FOR SIGN K/L, ALL PER JEFF STOCKTON, NO OTHER CHANGES. 05.26.20 R1 VT: REVISE SIGN D OAH SIZE TO 8' X 5'; ADD SIGNS K & L, ALL PER JEFF STOCKTON.

200337 R19 / 2 OF 13

MEMBER

NOTICE TO THE CUSTOMER
 Note: The colors depicted on this rendering may not match actual colors used on the finished display. Please refer to the detail drawing for the approved color specifications. Note: The cost of providing electrical wiring to the sign area, all required permits and all special inspections are not included in this sign proposal. Note: The proportion of signs shown on building & landscape area photos is an approximate representation.

CUSTOMER APPROVAL

ACCEPTED W/ NO CHANGES ACCEPTED W/ CHANGES AS NOTED
 REVISE AS NOTED AND RESUBMIT

BY _____ CUSTOMER BY _____ LANDLORD
 DATE _____ DATE _____

DATE	BY	DATE	BY
05.05.20	VT	12.23.20	VT
05.26.20	VT	01.12.21	VT
06.02.20	VT	01.14.21	VT
07.10.20	VT	01.19.21	VT
07.28.20	VT	01.19.21	VT
08.06.20	VT	02.18.21	VT
08.07.20	VT	04.13.21	VT
08.24.20	VT	04.18.21	VT
09.03.20	VT	05.05.21	VT
10.19.20	VT		

COMPANY OR JOB NAME / JOB DESCRIPTION **200337 R19**

76
SIGN PROGRAM

ADDRESS: **7337 ODAY ROAD VACAVILLE CALIFORNIA 95688**

SALESPERSON: **JEFF STOCKTON** CUSTOMER CONTACT: **XXXXXX**

NAME / DATE

© COPYRIGHT 2021 This drawing was created to assist you in visualizing our proposal. The original ideas herein are the property of Sign Designs. Permission to copy or revise this drawing can only be obtained thru a written agreement w/ Sign Designs. See your sales representative or call Sign Designs.

By signing this drawing document, I understand that I am not obligated to purchase this project, notwithstanding, the above artwork cannot be submitted for pricing, duplication and/or manufacturing to another sign company, architectural company or other business entity for the purpose or intent of manufacturing or for use as intellectual property, such as, but not limited to, a company logo, unless the represented logo was provided to Sign Designs by the customer and input into this drawing document by a Sign Designs employee.

NAME / DATE

2 OF 13



This sign is intended to be installed in accordance with the requirements of ARTICLE 600 of the national electrical code &/or other applicable codes. this includes proper grounding & bonding of the sign. The location of the disconnect switch after installation shall comply w/ ARTICLE 600.6(A)(1) of the National Electrical Code. All measures shown in this drawing are nominal until the "NOT FOR PRODUCTION" is removed

SIGNS A1 & A2: CANOPY LOGOS

SCOPE OF WORK: RECEIVE AND INSTALL (2) NEW INDIRECTLY ILLUMINATED ILLUMINATED CANOPY LOGOS ON FUEL CANOPY

NOTE: INDIRECT ILLUMINATION BY GOOSENECK LAMPS / HOOK TO ELECTRICAL SUPPLIED BY OTHERS

REMOVAL: NONE

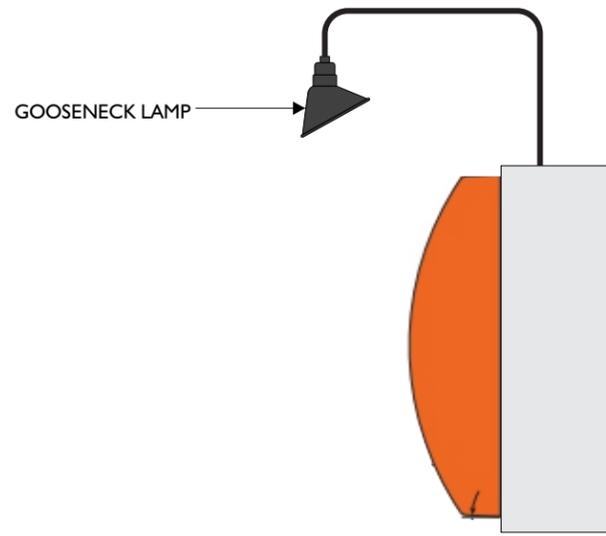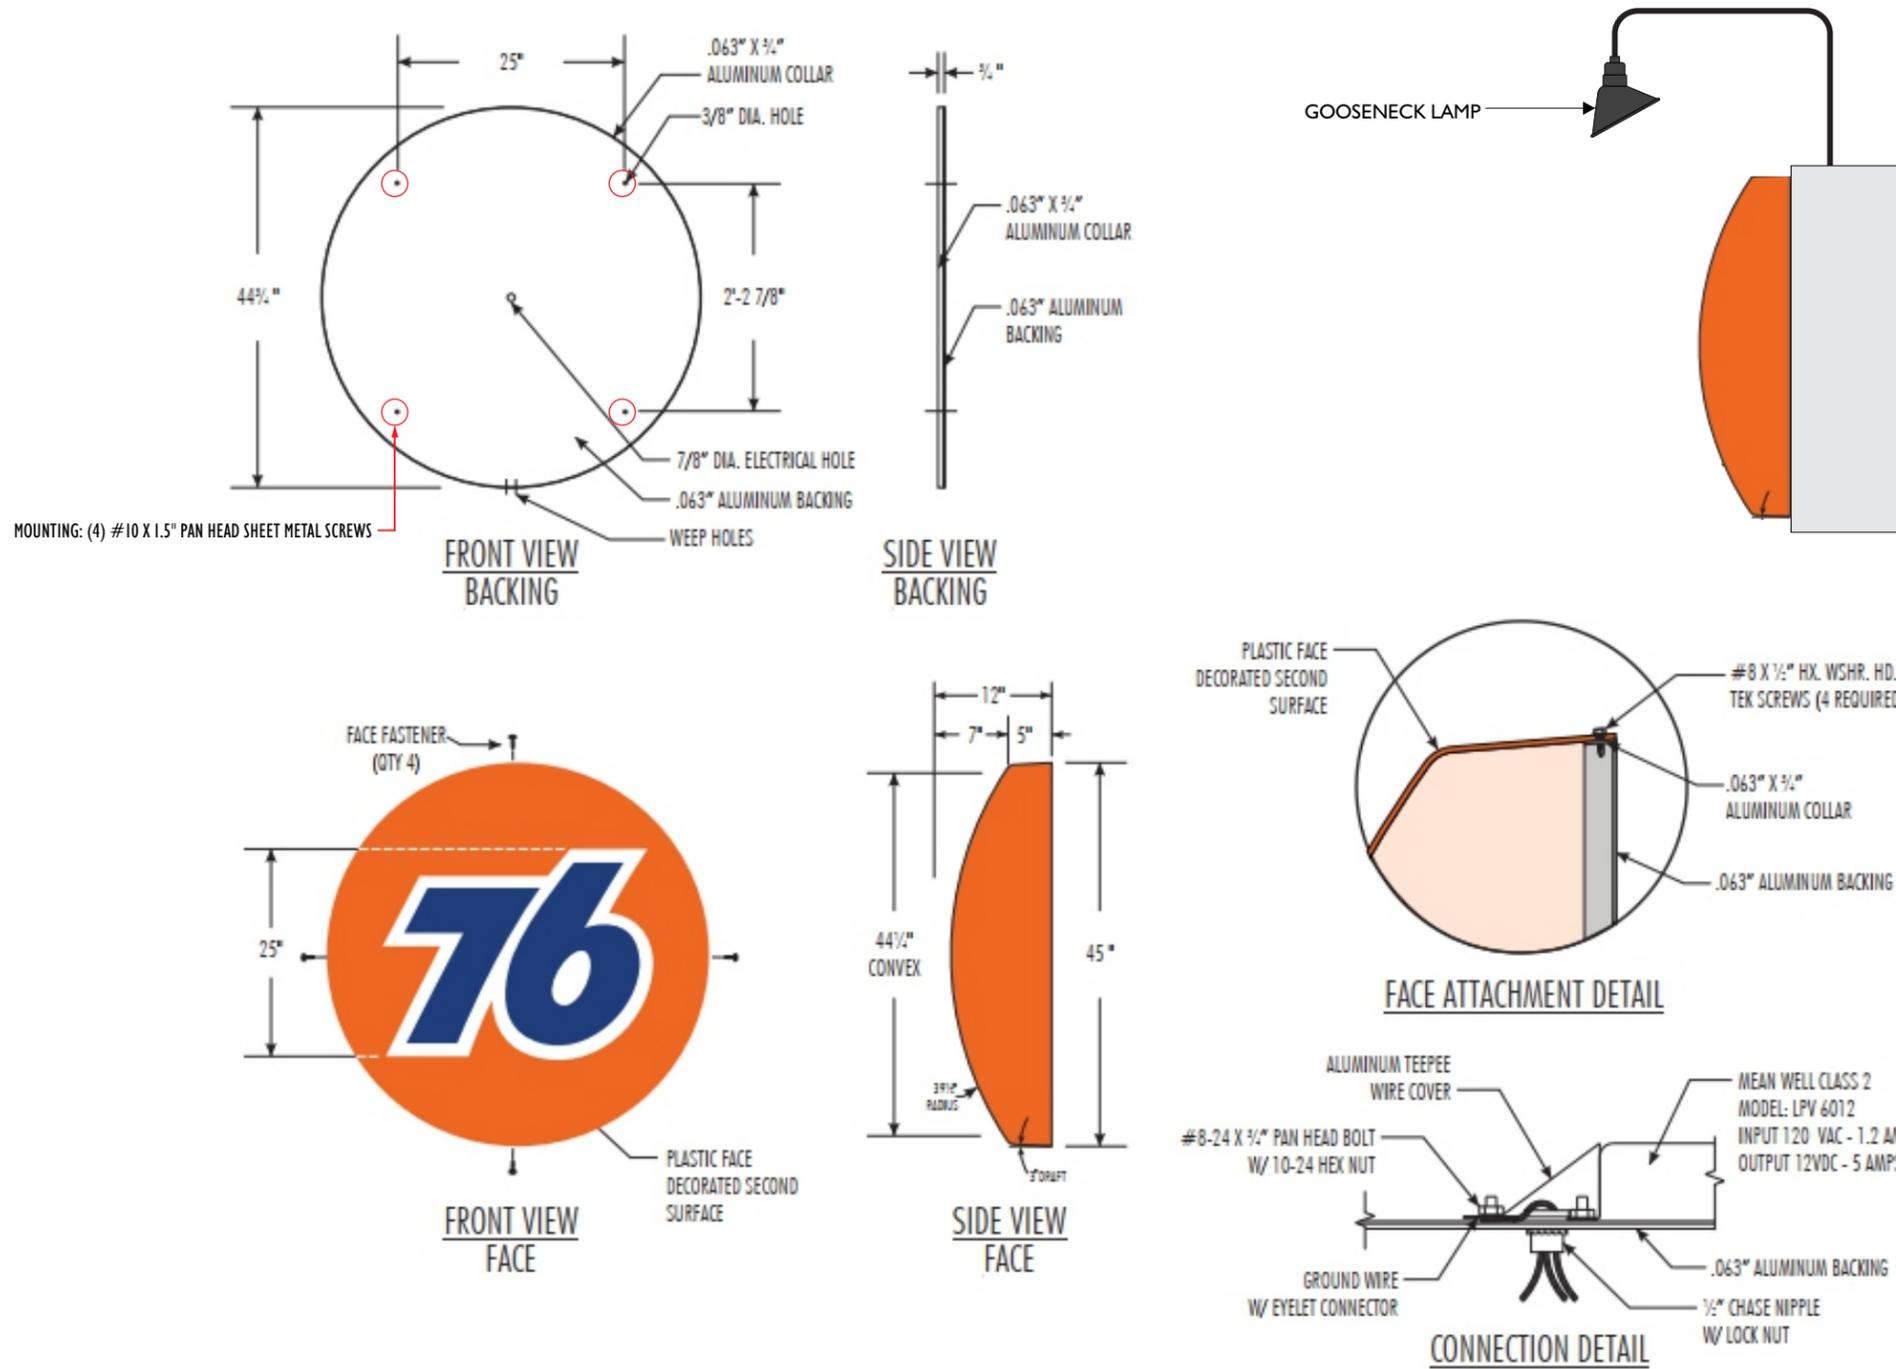

45" LOGO: 11 SF	
Paint	
PMS 165C	
PMS 287C	
Text	
Design Load	90 MPH

05.05.21 R19 VT: REVERT ILLUMINATION TO GOOSENECK LAMPS FOR SIGNS A, D & K. REVERT SIGN C TO R15 VERSION. ALL PER JEFF STOCKTON. NO OTHER CHANGES. 04.18.21 R18 VT: CHANGE SIGN D TO 12X5; ADD "REMOVED BY OTHERS" TO SIGN C. CABINET PER JEFF STOCKTON. NO OTHER CHANGES. 04.13.21 R17 VT: CHANGE SIGN D TO 6X5; CABINET PER JEFF STOCKTON. NO OTHER CHANGES. 02.18.21 R16 VT: REMOVE ALL GOOSENECK LAMPS AND REVERT TO LEDS; REVERT SIGN C TO OLD MONUMENT FROM R2. ALL PER JEFF STOCKTON. NO OTHER CHANGES. 01.19.21 R15 VT: REVERT CANOPY SIGNS A PER JEFF STOCKTON. NO OTHER CHANGES. 01.19.21 R14 VT: REMOVE "X" FROM TWIN POLE SIGN ON PHOTO (PG 12) PER STEVE LOCKE. NO OTHER CHANGES. 01.14.21 R13 VT: UPDATE ADDRESS AND UPDATE SIGN L TO 7337. PER JEFF STOCKTON. NO OTHER CHANGES. 01.12.21 R12 VT: VARIOUS REDLINE CHANGES PER STEVE LOCKE, JEFF STOCKTON. ADD SIGN L (PVC ADDRESS NUMERALS), REVISE SIGN K TO "STARS" CONVENIENCE STORE PER JEFF STOCKTON/CUSTOMER. 12.23.20 R10 VT: ADD GOOSENECK LAMPS TO SIGNS A, D & K. REPLACE SIGN C WITH NEW MONUMENT SIGN, ADD VARIOUS MEASUREMENTS TO EXISTING SIGN PHOTOS ALL PER JEFF STOCKTON. NO OTHER CHANGES. 10.19.20 R10 VT: MARK POLE SIGNS ARE "REMOVED" ON PG 11 PER STEVE LOCKE. NO OTHER CHANGES. 09.03.20 R9 VT: REVISE SIGN C NEW POLE & FOOTING PER JEFF STOCKTON. NO OTHER CHANGES. 08.24.20 R1 VT: ADD PHOTOS OF EXISTING SIGNS TO BE REMOVED PER JEFF STOCKTON. NO OTHER CHANGES. 08.12.20 R7 VT: CHANGE SIGN C OAH TO 19'-6" PER JEFF STOCKTON. NO OTHER CHANGES. 08.07.20 R6 VT: ADD VARIOUS MEASUREMENTS, UPDATE SIGN C MOUNTING DETAIL, ADD STAMPED ENGINEERING PAGE, ALL PER JEFF STOCKTON. NO OTHER CHANGES. 08.06.20 R5 VT: UPDATE SITE MAP PER JEFF STOCKTON. NO OTHER CHANGES. 07.28.20 R4 VT: SIGN D-SWAP DIESEL #2 AND 24 HOURS FACES, SIGN K- SWAP COLOR SCHEME ON BACKER PANEL PER JEFF STOCKTON/CUSTOMER. NO OTHER CHANGES. 07.10.20 R3 VT: REMOVE SIGN L, CHANGE SIGN K TO "A CONVENIENCE STORE" PANS ON BACKER, ADD MOUNTING DETAILS TO SIGN D, CHANGE SIGN C LEDS TO WHITE, ALL PER JEFF STOCKTON. NO OTHER CHANGES. 06.02.20 R2 VT: PUT SIGN C ON POLE, SHOW SIGN D AS HORIZ LAYOUT AND WRONG PROPORTIONS PER JEFF STOCKTON, UPDATE PHOTO FOR SIGN K/L, ALL PER JEFF STOCKTON. NO OTHER CHANGES. 05.26.20 R1 VT: REVISE SIGN D OAH SIZE TO 8' X 5'; ADD SIGNS K & L, ALL PER JEFF STOCKTON.

PERMIT DRAWING 200337 R19 / 3 OF 13

SDI SIGN DESIGNS
 INCORPORATED
 PO Box 4590 | 204 Campus Way Modesto Ca 95350 | O 209.524.4484 | F 209.521.0272 | Ca LIC#268001 | C-45 | Nv Lic#0082570 | C-6



NOTICE TO THE CUSTOMER Note: The colors depicted on this rendering may not match actual colors used on the finished display. Please refer to the detail drawing for the approved color specifications. Note: The cost of providing electrical wiring to the sign area, all required permits and all special inspections are not included in this sign proposal. Note: The proportion of signs shown on building & landscape area photos is an approximate representation.	CUSTOMER APPROVAL <input type="checkbox"/> ACCEPTED W/ NO CHANGES <input type="checkbox"/> ACCEPTED W/ CHANGES AS NOTED <input type="checkbox"/> REVISE AS NOTED AND RESUBMIT		DATE BY DATE BY	COMPANY OR JOB NAME / JOB DESCRIPTION 200337 R19 76 SIGN PROGRAM
	BY _____ CUSTOMER BY _____ LANDLORD DATE _____ DATE _____	05.05.20 VT 12.23.20 VT 05.26.20 VT 01.12.21 VT 06.02.20 VT 01.14.21 VT 07.10.20 VT 01.19.21 VT 07.28.20 VT 01.19.21 VT 08.06.20 VT 02.18.21 VT 08.07.20 VT 04.13.21 VT 08.24.20 VT 04.18.21 VT 09.03.20 VT 05.05.21 VT 10.19.20 VT	ADDRESS: 7337 ODAY ROAD VACAVILLE CALIFORNIA 95688 SALESPERSON: JEFF STOCKTON CUSTOMER CONTACT: XXXXXX	
© COPYRIGHT 2021 This drawing was created to assist you in visualizing our proposal. The original ideas herein are the property of Sign Designs. Permission to copy or revise this drawing can only be obtained thru a written agreement w/ Sign Designs. See your sales representative or call Sign Designs.	By signing this drawing document, I understand that I am not obligated to purchase this project, notwithstanding, the above artwork cannot be submitted for pricing, duplication and/or manufacturing to another sign company, architectural company or other business entity for the purpose or intent of manufacturing or for use as intellectual property, such as, but not limited to, a company logo, unless the represented logo was provided to Sign Designs by the customer and input into this drawing document by a Sign Designs employee.		NAME / DATE	3 OF 13

This sign is intended to be installed in accordance with the requirements of ARTICLE 600 of the national electrical code &/or other applicable codes. this includes proper grounding & bonding of the sign. The location of the disconnect switch after installation shall comply w/ ARTICLE 600.6(A)(1) of the National Electrical Code. All measures shown in this drawing are nominal until the "NOT FOR PRODUCTION" is removed

SIGN B: CANOPY IMAGE


SCOPE OF WORK: RECEIVE AND INSTALL (1) SET OF CANOPY FASCIA PANELS

NOTE: HOOK TO ELECTRICAL SUPPLIED BY OTHERS
REMOVAL: NONE

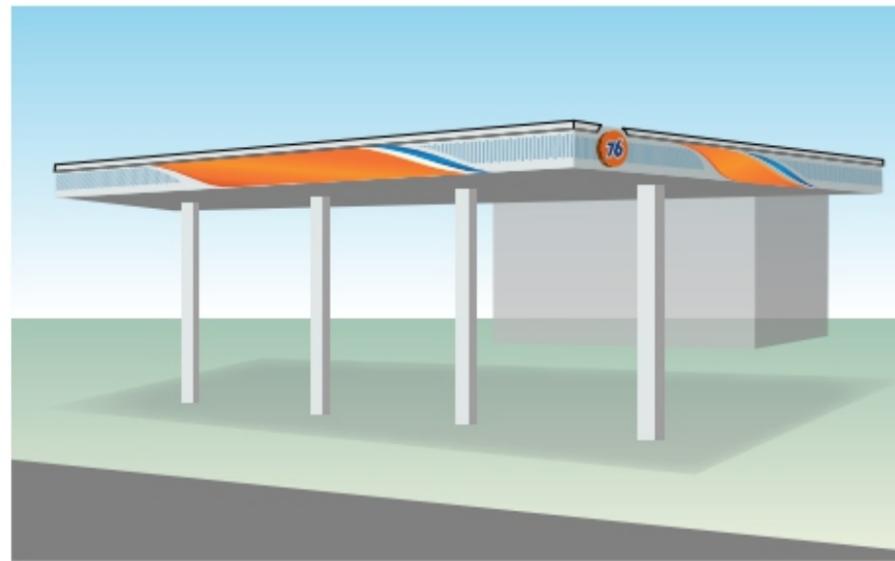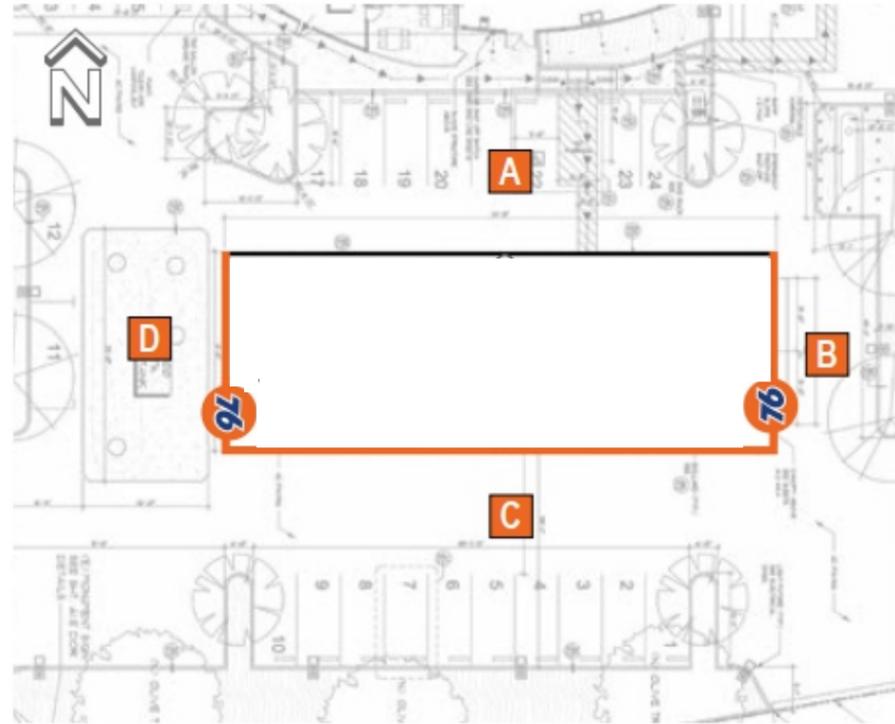


CANOPY PERSPECTIVE


ELEVATION A: NON-ILLUMINATED

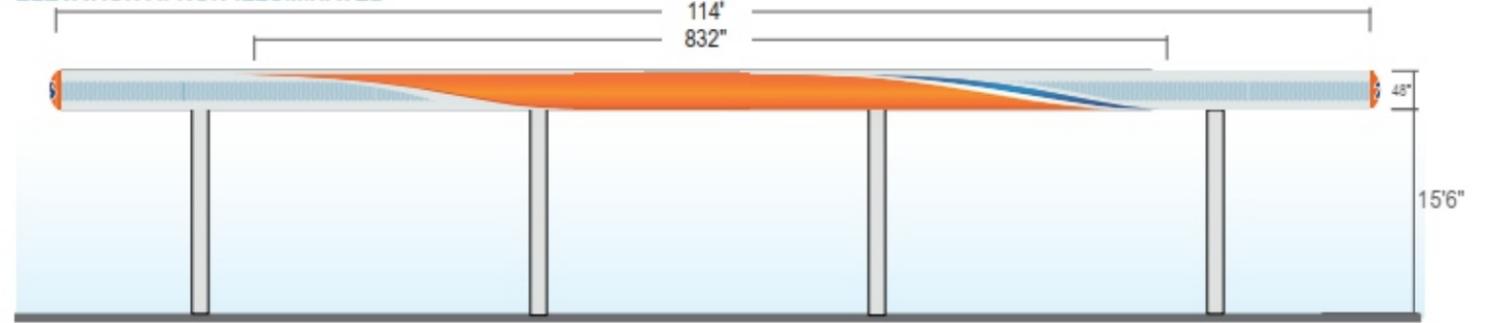


ELEVATION B: ILLUMINATED

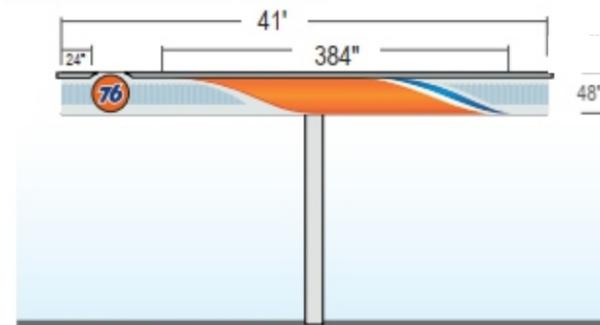

ELEVATION C: ILLUMINATED

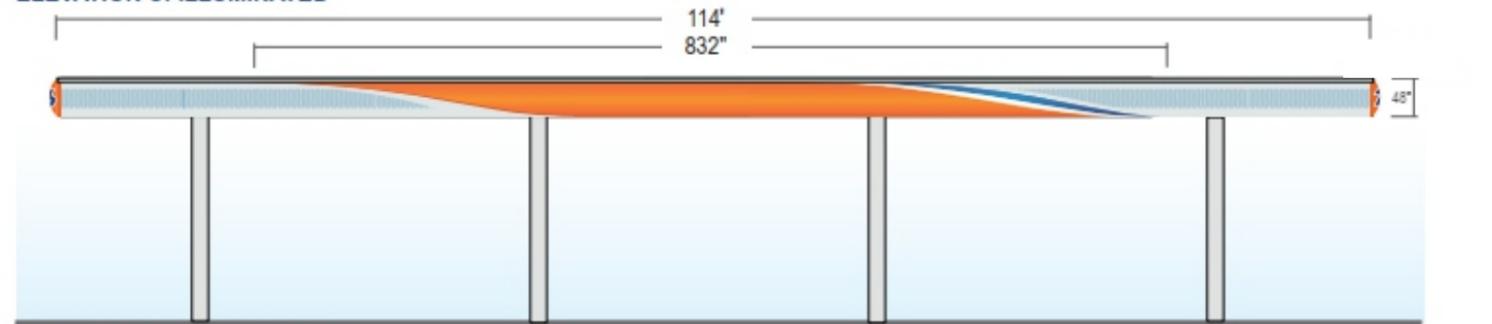

ELEVATION D: ILLUMINATED

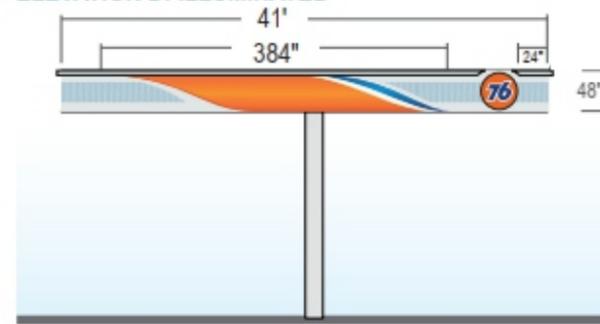

05.05.21 R19 VT: REVERT ILLUMINATION TO GOOSENECK LAMPS FOR SIGNS A, D & K. REVERT SIGN C TO R15 VERSION. ALL PER JEFF STOCKTON. NO OTHER CHANGES. 04.18.21 R18 VT: CHANGE SIGN D TO 12X5; ADD "REMOVED BY OTHERS" TO SIGN C. CABINET PER JEFF STOCKTON. NO OTHER CHANGES. 04.13.21 R17 VT: CHANGE SIGN D TO 6X5; CABINET PER JEFF STOCKTON. NO OTHER CHANGES. 02.18.21 R16 VT: REMOVE ALL GOOSENECK LAMPS AND REVERT TO LEDS; REVERT SIGN C TO OLD MONUMENT FROM R2. ALL PER JEFF STOCKTON. NO OTHER CHANGES. 01.19.21 R15 VT: REVERT CANOPY SIGNS A PER JEFF STOCKTON. NO OTHER CHANGES. 01.19.21 R14 VT: REMOVE "X" FROM TWIN POLE SIGN ON PHOTO (PG 12) PER STEVE LOCKE. NO OTHER CHANGES. 01.14.21 R13 VT: UPDATE ADDRESS AND UPDATE SIGN L TO 7337. PER JEFF STOCKTON. NO OTHER CHANGES. 01.12.21 R12 VT: VARIOUS REDLINE CHANGES PER STEVE LOCKE. JEFF STOCKTON. ADD SIGN L (PVC ADDRESS NUMERALS). REVISE SIGN K TO "STARS" CONVENIENCE STORE PER JEFF STOCKTON/CUSTOMER. 12.23.20 R10 VT: ADD GOOSENECK LAMPS TO SIGNS A,D & K. REPLACE SIGN C WITH NEW MONUMENT SIGN. ADD VARIOUS MEASUREMENTS TO EXISTING SIGN PHOTOS ALL PER JEFF STOCKTON. NO OTHER CHANGES. 10.19.20 R10 VT: MARK POLE SIGNS ARE "REMOVED" ON PG 11 PER STEVE LOCKE. NO OTHER CHANGES. 09.03.20 R9 VT: REVISE SIGN C NEW POLE & FOOTING PER JEFF STOCKTON. NO OTHER CHANGES. 08.24.20 R1 VT: ADD PHOTOS OF EXISTING SIGNS TO BE REMOVED PER JEFF STOCKTON. NO OTHER CHANGES. 08.12.20 R7 VT: CHANGE SIGN C OAH TO 19'-6" PER JEFF STOCKTON. NO OTHER CHANGES. 08.07.20 R6 VT: ADD VARIOUS MEASUREMENTS. UPDATE SIGN C MOUNTING DETAIL. ADD STAMPED ENGINEERING PAGE. ALL PER JEFF STOCKTON. NO OTHER CHANGES. 08.06.20 R5 VT: UPDATE SITE MAP PER JEFF STOCKTON. NO OTHER CHANGES. 07.28.20 R4 VT: SIGN D-SWAP DIESEL #2 AND 24 HOURS FACES. SIGN K- SWAP COLOR SCHEME ON BACKER PANEL PER JEFF STOCKTON/CUSTOMER. NO OTHER CHANGES. 07.10.20 R3 VT: REMOVE SIGN L. CHANGE SIGN K TO "A CONVENIENCE STORE" PANS ON BACKER. ADD MOUNTING DETAILS TO SIGN D. CHANGE SIGN C LEDS TO WHITE. ALL PER JEFF STOCKTON. NO OTHER CHANGES. 06.02.20 R2 VT: PUT SIGN C ON POLE. SHOW SIGN D AS HORZ LAYOUT AND WRONG PROPORTIONS PER JEFF STOCKTON. UPDATE PHOTO FOR SIGN K/L. ALL PER JEFF STOCKTON. NO OTHER CHANGES. 05.26.20 R1 VT: REVISE SIGN D OAH SIZE TO 8' X 5'; ADD SIGNS K & L. ALL PER JEFF STOCKTON.

PERMIT DRAWING

200337 R19 / 4 OF 13



PO Box 4590 | 204 Campus Way Modesto Ca 95350 | O 209.524.4484 | F 209.521.0272 | Ca LIC#268001 | C-45 | Nv Lic#0082570 | C-6



NOTICE TO THE CUSTOMER

Note: The colors depicted on this rendering may not match actual colors used on the finished display. Please refer to the detail drawing for the approved color specifications. Note: The cost of providing electrical wiring to the sign area, all required permits and all special inspections are not included in this sign proposal. Note: The proportion of signs shown on building & landscape area photos is an approximate representation.

CUSTOMER APPROVAL

ACCEPTED W/ NO CHANGES ACCEPTED W/ CHANGES AS NOTED

REVISE AS NOTED AND RESUBMIT

BY _____ CUSTOMER BY _____ LANDLORD

DATE _____ DATE _____

DATE	BY	DATE	BY
05.05.20	VT	12.23.20	VT
05.26.20	VT	01.12.21	VT
06.02.20	VT	01.14.21	VT
07.10.20	VT	01.19.21	VT
07.28.20	VT	01.19.21	VT
08.06.20	VT	02.18.21	VT
08.07.20	VT	04.13.21	VT
08.24.20	VT	04.18.21	VT
09.03.20	VT	05.05.21	VT
10.19.20	VT		

COMPANY OR JOB NAME / JOB DESCRIPTION		200337 R19
76 SIGN PROGRAM		
ADDRESS: 7337 ODAY ROAD VACAVILLE CALIFORNIA 95688		
SALESPERSON: JEFF STOCKTON		
CUSTOMER CONTACT: XXXXX		
NAME / DATE		

© 2021


This drawing was created to assist you in visualizing our proposal. The original ideas herein are the property of Sign Designs. Permission to copy or revise this drawing can only be obtained thru a written agreement w/ Sign Designs. See your sales representative or call Sign Designs.

By signing this drawing document, I understand that I am not obligated to purchase this project, notwithstanding, the above artwork cannot be submitted for pricing, duplication and/or manufacturing to another sign company, architectural company or other business entity for the purpose or intent of manufacturing or for use as intellectual property, such as, but not limited to, a company logo, unless the represented logo was provided to Sign Designs by the customer and input into this drawing document by a Sign Designs employee.

76 Crest LED Light Bar Signature Image



76 Crest LED Light Bar Installation Guide

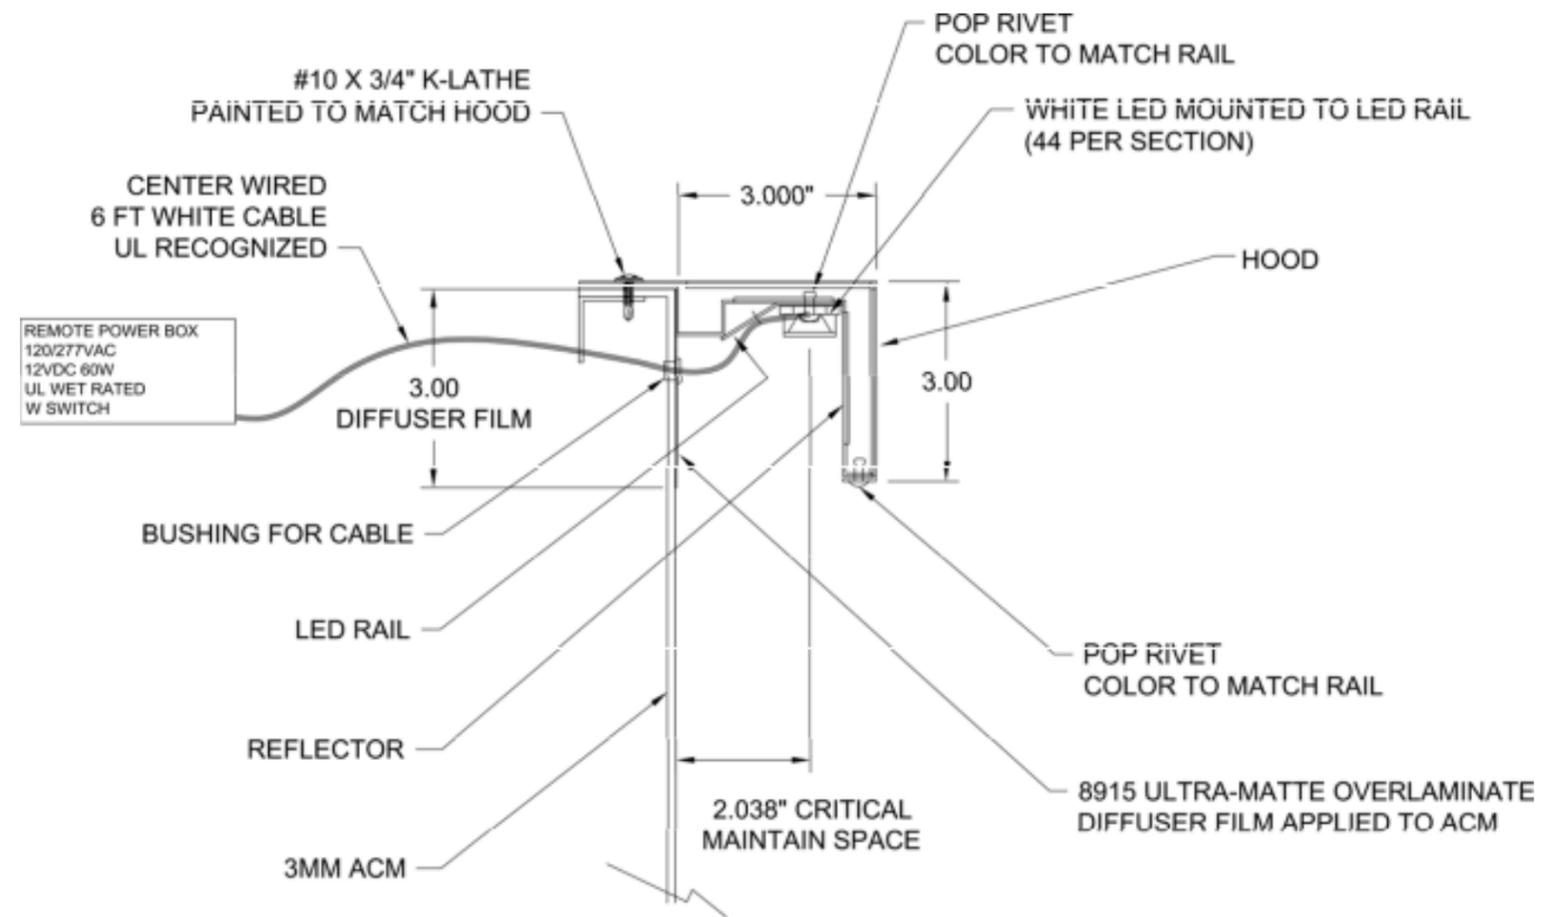

05.05.21 R19 VT: REVERT ILLUMINATION TO GOOSENECK LAMPS FOR SIGNS A, D & K. REVERT SIGN C TO R15 VERSION. ALL PER JEFF STOCKTON. NO OTHER CHANGES. 04.18.21 R18 VT: CHANGE SIGN D TO 12X5. ADD "REMOVED BY OTHERS" TO SIGN C. CABINET PER JEFF STOCKTON. NO OTHER CHANGES. 04.13.21 R17 VT: CHANGE SIGN D TO 6X5. CABINET PER JEFF STOCKTON. NO OTHER CHANGES. 02.18.21 R16 VT: REMOVE ALL GOOSENECK LAMPS AND REVERT TO LEDS. REVERT SIGN C TO OLD MONUMENT FROM R2. ALL PER JEFF STOCKTON. NO OTHER CHANGES. 01.19.21 R15 VT: REVERT CANOPY SIGNS A PER JEFF STOCKTON. NO OTHER CHANGES. 01.19.21 R14 VT: REMOVE "X" FROM TWIN POLE SIGN ON PHOTO (PG 12) PER STEVE LOCKE. NO OTHER CHANGES. 01.14.21 R13 VT: UPDATE ADDRESS AND UPDATE SIGN L TO 7337. PER JEFF STOCKTON. NO OTHER CHANGES. 01.12.21 R12 VT: VARIOUS REDLINE CHANGES PER STEVE LOCKE, JEFF STOCKTON. ADD SIGN L (PVC ADDRESS NUMERALS). REVISE SIGN K TO "STARS" CONVENIENCE STORE PER JEFF STOCKTON/CUSTOMER. 12.23.20 R10 VT: ADD GOOSENECK LAMPS TO SIGNS A, D & K. REPLACE SIGN C WITH NEW MONUMENT SIGN. ADD VARIOUS MEASUREMENTS TO EXISTING SIGN PHOTOS ALL PER JEFF STOCKTON. NO OTHER CHANGES. 10.19.20 R10 VT: MARK POLE SIGNS ARE "REMOVED" ON PG 11 PER STEVE LOCKE. NO OTHER CHANGES. 09.03.20 R9 VT: REVISE SIGN C NEW POLE & FOOTING PER JEFF STOCKTON. NO OTHER CHANGES. 08.24.20 R1 VT: ADD PHOTOS OF EXISTING SIGNS TO BE REMOVED PER JEFF STOCKTON. NO OTHER CHANGES. 08.12.20 R7 VT: CHANGE SIGN C OAH TO 19'-6" PER JEFF STOCKTON. NO OTHER CHANGES. 08.07.20 R6 VT: ADD VARIOUS MEASUREMENTS. UPDATE SIGN C MOUNTING DETAIL. ADD STAMPED ENGINEERING PAGE. ALL PER JEFF STOCKTON. NO OTHER CHANGES. 08.06.20 R5 VT: UPDATE SITE MAP PER JEFF STOCKTON. NO OTHER CHANGES. 07.28.20 R4 VT: SIGN D-SWAP DIESEL #2 AND 24 HOURS FACES. SIGN K- SWAP COLOR SCHEME ON BACKER PANEL PER JEFF STOCKTON/CUSTOMER. NO OTHER CHANGES. 07.10.20 R3 VT: REMOVE SIGN L. CHANGE SIGN K TO "A CONVENIENCE STORE" PANS ON BACKER. ADD MOUNTING DETAILS TO SIGN D. CHANGE SIGN C LEDS TO WHITE. ALL PER JEFF STOCKTON. NO OTHER CHANGES. 06.02.20 R2 VT: PUT SIGN C ON POLE. SHOW SIGN D AS HORZ LAYOUT AND WRONG PROPORTIONS PER JEFF STOCKTON. UPDATE PHOTO FOR SIGN K/L. ALL PER JEFF STOCKTON. NO OTHER CHANGES. 05.26.20 R1 VT: REVISE SIGN D OAH SIZE TO 8' X 5'. ADD SIGNS K & L. ALL PER JEFF STOCKTON.

PERMIT DRAWING

200337 R19 / 5 OF 13



PO Box 4590 | 204 Campus Way Modesto Ca 95350 | O 209.524.4484 | F 209.521.0272 | Ca LIC#268001 | C-45 | Nv Lic#0082570 | C-6



NOTICE TO THE CUSTOMER

Note: The colors depicted on this rendering may not match actual colors used on the finished display. Please refer to the detail drawing for the approved color specifications. Note: The cost of providing electrical wiring to the sign area, all required permits and all special inspections are not included in this sign proposal. Note: The proportion of signs shown on building & landscape area photos is an approximate representation.

CUSTOMER APPROVAL

ACCEPTED W/ NO CHANGES ACCEPTED W/ CHANGES AS NOTED
 REVISE AS NOTED AND RESUBMIT

BY CUSTOMER BY LANDLORD
 DATE _____ DATE _____

DATE	BY	DATE	BY
05.05.20	VT	12.23.20	VT
05.26.20	VT	01.12.21	VT
06.02.20	VT	01.14.21	VT
07.10.20	VT	01.19.21	VT
07.28.20	VT	01.19.21	VT
08.06.20	VT	02.18.21	VT
08.07.20	VT	04.13.21	VT
08.24.20	VT	04.18.21	VT
09.03.20	VT	05.05.21	VT
10.19.20	VT		

COMPANY OR JOB NAME / JOB DESCRIPTION

200337 R19

76
SIGN PROGRAM

ADDRESS: **7337 ODAY ROAD VACAVILLE CALIFORNIA 95688**

SALESPERSON: **JEFF STOCKTON** CUSTOMER CONTACT: **XXXXXX**

© 2021

This drawing was created to assist you in visualizing our proposal. The original ideas herein are the property of Sign Designs. Permission to copy or revise this drawing can only be obtained thru a written agreement w/ Sign Designs. See your sales representative or call Sign Designs.

By signing this drawing document, I understand that I am not obligated to purchase this project, notwithstanding, the above artwork cannot be submitted for pricing, duplication and/or manufacturing to another sign company, architectural company or other business entity for the purpose or intent of manufacturing or for use as intellectual property, such as, but not limited to, a company logo, unless the represented logo was provided to Sign Designs by the customer and input into this drawing document by a Sign Designs employee.

NAME / DATE

5 OF 13

This sign is intended to be installed in accordance with the requirements of ARTICLE 600 of the national electrical code &/or other applicable codes. this includes proper grounding & bonding of the sign. The location of the disconnect switch after installation shall comply w/ ARTICLE 600.6(A)(1) of the National Electrical Code. All measures shown in this drawing are nominal until the "NOT FOR PRODUCTION" is removed


SIGN C: MAIN ID SIGN

NOTE: HOOK TO ELECTRICAL SUPPLIED BY OTHERS

NOTE: FOOTING MAY REQUIRE CONCRETE MOWPAD

REMOVAL: REMOVE EXISTING TWIN POLE SIGN AND LEAVE WITH CUSTOMER

SCOPE OF WORK: RECEIVE AND INSTALL NEW MONUMENT SIGN / 48.125 SQUARE FEET

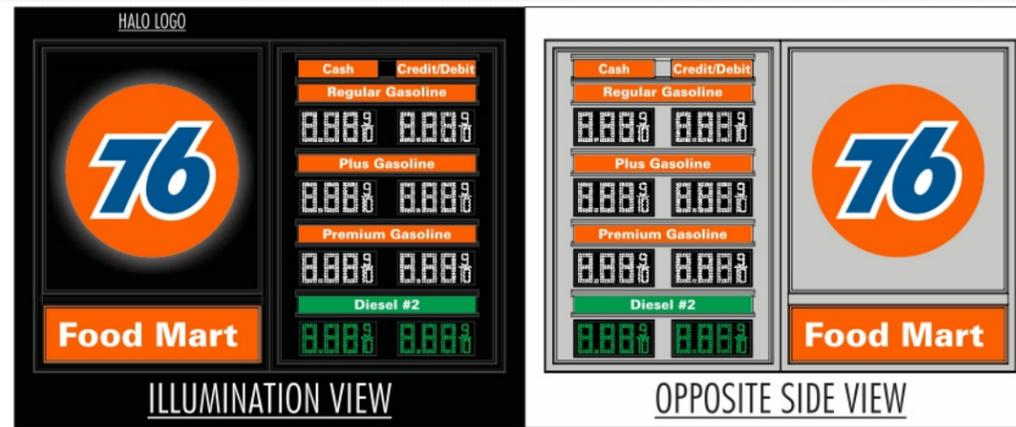




PART # PCRV0456 (REFERENCE ONLY)
CLEAR COPY ON TRANSLUCENT ORANGE / GREEN BACKGROUND



WORDPLATES
PART # PCRV0660 (REFERENCE ONLY)
CLEAR COPY ON TRANSLUCENT ORANGE BACKGROUND



GRADE COPY WORDPLATES

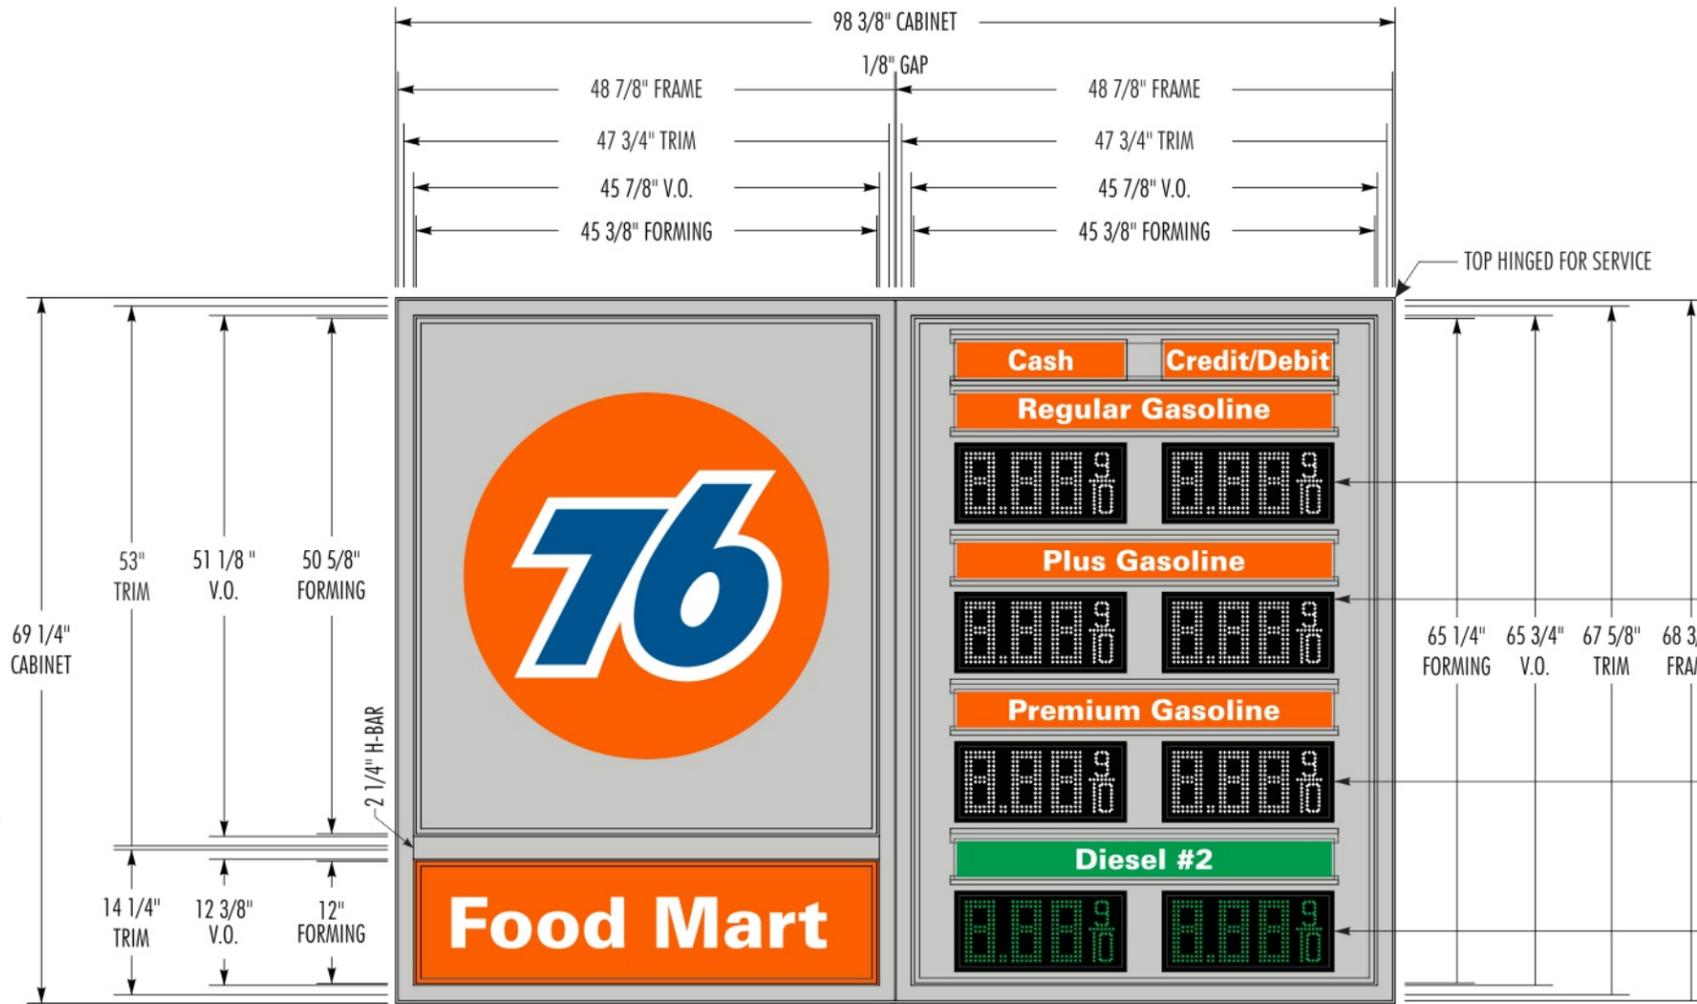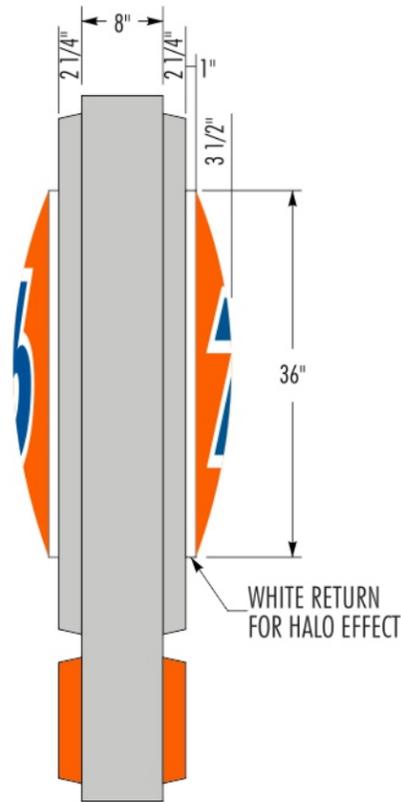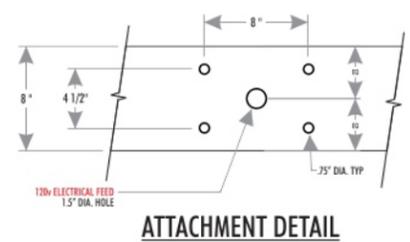

6" WHITE ABLE MULTI-SEG LEDS
LED WINDOW: 8" X 17"
LED V.O.: 7" X 16"

6" WHITE ABLE MULTI-SEG LEDS
LED WINDOW: 8" X 17"
LED V.O.: 7" X 16"

6" WHITE ABLE MULTI-SEG LEDS
LED WINDOW: 8" X 17"
LED V.O.: 7" X 16"

6" GREEN ABLE MULTI-SEG LEDS
LED WINDOW: 8" X 17"
LED V.O.: 7" X 16"

DISCONNECT SWITCH

NOTE: CABINET TO BE LED ILLUMINATED
TO BE MANUFACTURED WITH **ABLE LEDS - 1CPAAT06W606G2-MSDS**

SIDE VIEW

FRONT VIEW

SIDE VIEW

05.05.21 R19 VT: REVERT ILLUMINATION TO GOOSENECK LAMPS FOR SIGNS A, D & K. REVERT SIGN C TO R15 VERSION. ALL PER JEFF STOCKTON, NO OTHER CHANGES. 04.18.21 R18 VT: CHANGE SIGN D TO 12X6; ADD "REMOVED BY OTHERS" TO SIGN C, CABINET PER JEFF STOCKTON, NO OTHER CHANGES. 04.13.21 R17 VT: CHANGE SIGN D TO 6X5; CABINET PER JEFF STOCKTON, NO OTHER CHANGES. 02.18.21 R16 VT: REMOVE ALL GOOSENECK LAMPS AND REVERT TO LEDS; REVERT SIGN C TO OLD MONUMENT FROM R2. ALL PER JEFF STOCKTON, NO OTHER CHANGES. 01.19.21 R15 VT: REVERT CANOPY SIGNS A PER JEFF STOCKTON, NO OTHER CHANGES. 01.19.21 R14 VT: REMOVE "X" FROM TWIN POLE SIGN ON PHOTO (PG 12) PER STEVE LOCKE, NO OTHER CHANGES. 01.14.21 R13 VT: UPDATE ADDRESS AND UPDATE SIGN L TO 7337. PER JEFF STOCKTON, NO OTHER CHANGES. 01.12.21 R12 VT: VARIOUS REDLINE CHANGES PER STEVE LOCKE, JEFF STOCKTON, ADD SIGN L (PVC ADDRESS NUMERALS), REVISE SIGN K TO "STARS" CONVENIENCE STORE PER JEFF STOCKTON/CUSTOMER. 12.23.20 R10 VT: ADD GOOSENECK LAMPS TO SIGNS A, D & K, REPLACE SIGN C WITH NEW MONUMENT SIGN, ADD VARIOUS MEASUREMENTS TO EXISTING SIGN PHOTOS ALL PER JEFF STOCKTON, NO OTHER CHANGES. 10.19.20 R10 VT: MARK POLE SIGNS ARE "REMOVED" ON PG 11 PER STEVE LOCKE, NO OTHER CHANGES. 09.03.20 R9 VT: REVISE SIGN C NEW POLE & FOOTING PER JEFF STOCKTON, NO OTHER CHANGES. 08.24.20 R1 VT: ADD PHOTOS OF EXISTING SIGNS TO BE REMOVED PER JEFF STOCKTON, NO OTHER CHANGES. 08.12.20 R7 VT: CHANGE SIGN C OAH TO 19'-6" PER JEFF STOCKTON, NO OTHER CHANGES. 08.07.20 R6 VT: ADD VARIOUS MEASUREMENTS, UPDATE SIGN C MOUNTING DETAIL, ADD STAMPED ENGINEERING PAGE, ALL PER JEFF STOCKTON, NO OTHER CHANGES. 08.06.20 R5 VT: UPDATE SITE MAP PER JEFF STOCKTON, NO OTHER CHANGES. 07.28.20 R4 VT: SIGN D-SWAP DIESEL #2 AND 24 HOURS FACES, SIGN K- SWAP COLOR SCHEME ON BACKER PANEL PER JEFF STOCKTON/CUSTOMER, NO OTHER CHANGES. 07.10.20 R3 VT: REMOVE SIGN L, CHANGE SIGN K TO "A CONVENIENCE STORE" PANS ON BACKER, ADD MOUNTING DETAILS TO SIGN D, CHANGE SIGN C LEDS TO WHITE, ALL PER JEFF STOCKTON, NO OTHER CHANGES. 06.02.20 R2 VT: PUT SIGN C ON POLE, SHOW SIGN D AS HORZ LAYOUT AND WRONG PROPORTIONS PER JEFF STOCKTON, UPDATE PHOTO FOR SIGN K/L, ALL PER JEFF STOCKTON, NO OTHER CHANGES. 05.26.20 R1 VT: REVISE SIGN D OAH SIZE TO 8' X 5', ADD SIGNS K & L, ALL PER JEFF STOCKTON.

PERMIT DRAWING

SD SIGN DESIGNS INCORPORATED

PO Box 4590 | 204 Campus Way Modesto Ca 95350 | O 209.524.4484 | F 209.521.0272 | Ca LIC#268001 | C-45 | Nv Lic#0082570 | C-6

MEMBER
SA California Sign Association
WSA
ISA INTERNATIONAL SIGN ASSOCIATION

NOTICE TO THE CUSTOMER

Note: The colors depicted on this rendering may not match actual colors used on the finished display. Please refer to the detail drawing for the approved color specifications. Note: The cost of providing electrical wiring to the sign area, all required permits and all special inspections are not included in this sign proposal. Note: The proportion of signs shown on building & landscape area photos is an approximate representation.

CUSTOMER APPROVAL

ACCEPTED W/ NO CHANGES ACCEPTED W/ CHANGES AS NOTED
 REVISE AS NOTED AND RESUBMIT

BY: CUSTOMER BY: LANDLORD
DATE: _____ DATE: _____

DATE	BY	DATE	BY	COMPANY OR JOB NAME / JOB DESCRIPTION	200337 R19		
05.05.20	VT	12.23.20	VT	76 SIGN PROGRAM			
05.26.20	VT	01.12.21	VT				
06.02.20	VT	01.14.21	VT				
07.10.20	VT	01.19.21	VT				
07.28.20	VT	01.19.21	VT				
08.06.20	VT	02.18.21	VT				
08.07.20	VT	04.13.21	VT				
08.24.20	VT	04.18.21	VT				
09.03.20	VT	05.05.21	VT				
10.19.20	VT						
ADDRESS: 7337 ODAY ROAD VACAVILLE CALIFORNIA 95688						CUSTOMER CONTACT: XXXXXX	
SALESPERSON: JEFF STOCKTON						NAME / DATE	6 OF 13

SIGN C: MAIN ID SIGN

EXISTING / TO BE RELOCATED BY OTHERS



AFTER (NEW MONUMENT SIGN 6'-0" FROM EXISTING SIGN)



05.05.21 R19 VT: REVERT ILLUMINATION TO GOOSENECK LAMPS FOR SIGNS A, D & K. REVERT SIGN C TO R15 VERS... 01.19.21 R15 VT: REVERT CANOPY SIGNS A PER JEFF STOCKTON. NO OTHER CHANGES. 01.19.21 R15 VT: REMOVE "A" FROM FRONT POLE SIGN ON PHOTO FOR STEVE LOCKE. NO OTHER CHANGES. 01.19.21 R15 VT: UPDATE ADDRESS AND DATE SIGN TO 7337 ODAY ROAD VACAVILLE, CA 95688. NO OTHER CHANGES. 01.19.21 R15 VT: ADD PHOTOS OF EXISTING SIGNS TO BE REMOVED PER JEFF STOCKTON/CUSTOMER. NO OTHER CHANGES. 12.23.20 R10 VT: ADD GOOSENECK LAMPS TO SIGNS A, D & K. REPLACE SIGN C WITH NEW MONUMENT SIGN. ADD VARIOUS MEASUREMENTS TO EXISTING SIGN PHOTOS ALL PER JEFF STOCKTON. NO OTHER CHANGES. 10.19.20 R10 VT: MARK POLE SIGNS ARE "REMOVED" ON PG 11 PER STEVE LOCKE. NO OTHER CHANGES. 09.03.20 R9 VT: REVISE SIGN C NEW POLE & FOOTING PER JEFF STOCKTON. NO OTHER CHANGES. 08.24.20 R1 VT: ADD PHOTOS OF EXISTING SIGNS TO BE REMOVED PER JEFF STOCKTON. NO OTHER CHANGES. 08.12.20 R7 VT: CHANGE SIGN C OAH TO 19'-6" PER JEFF STOCKTON. NO OTHER CHANGES. 08.07.20 R6 VT: ADD VARIOUS MEASUREMENTS. UPDATE SIGN C MOUNTING DETAIL. ADD STAMPED ENGINEERING PAGE. ALL PER JEFF STOCKTON. NO OTHER CHANGES. 08.06.20 R5 VT: UPDATE SITE MAP PER JEFF STOCKTON. NO OTHER CHANGES. 07.28.20 R4 VT: SIGN D-SWAP DIESEL #2 AND 24 HOURS FACES. SIGN K- SWAP COLOR SCHEME ON BACKER PANEL PER JEFF STOCKTON/CUSTOMER. NO OTHER CHANGES. 07.10.20 R3 VT: REMOVE SIGN L. CHANGE SIGN K TO "A CONVENIENCE STORE" PANS ON BACKER. ADD MOUNTING DETAILS TO SIGN D. CHANGE SIGN C LEDS TO WHITE. ALL PER JEFF STOCKTON. NO OTHER CHANGES. 06.02.20 R2 VT: PUT SIGN C ON POLE. SHOW SIGN D AS HORIZ LAYOUT AND WRONG PROPORTIONS PER JEFF STOCKTON. UPDATE PHOTO FOR SIGN K/L. ALL PER JEFF STOCKTON. NO OTHER CHANGES. 05.26.20 R1 VT: REVISE SIGN D OAH SIZE TO 8' X 5'. ADD SIGNS K & L. ALL PER JEFF STOCKTON.

PERMIT DRAWING

200337 R19 / 7 OF 13

PO Box 4590 | 204 Campus Way Modesto Ca 95350 | O 209.524.4484 | F 209.521.0272 | Ca LIC#268001 | C-45 | Nv Lic#0082570 | C-6

MEMBER
 California Sign Association
 Western Sign Association
 INTERNATIONAL SIGN ASSOCIATION

NOTICE TO THE CUSTOMER
 Note: The colors depicted on this rendering may not match actual colors used on the finished display. Please refer to the detail drawing for the approved color specifications. Note: The cost of providing electrical wiring to the sign area, all required permits and all special inspections are not included in this sign proposal. Note: The proportion of signs shown on building & landscape area photos is an approximate representation.

CUSTOMER APPROVAL

ACCEPTED W/ NO CHANGES ACCEPTED W/ CHANGES AS NOTED
 REVISE AS NOTED AND RESUBMIT

BY _____ CUSTOMER BY _____ LANDLORD
 DATE _____ DATE _____

DATE	BY	DATE	BY
05.05.20	VT	12.23.20	VT
05.26.20	VT	01.12.21	VT
06.02.20	VT	01.14.21	VT
07.10.20	VT	01.19.21	VT
07.28.20	VT	01.19.21	VT
08.06.20	VT	02.18.21	VT
08.07.20	VT	04.13.21	VT
08.24.20	VT	04.18.21	VT
09.03.20	VT	05.05.21	VT
10.19.20	VT		

COMPANY OR JOB NAME / JOB DESCRIPTION **200337 R19**

76 SIGN PROGRAM

ADDRESS: **7337 ODAY ROAD VACAVILLE CALIFORNIA 95688**

SALESPERSON: **JEFF STOCKTON** CUSTOMER CONTACT: **XXXXXX**

DATE: _____ NAME / DATE _____

© 2021

This drawing was created to assist you in visualizing our proposal. The original ideas herein are the property of Sign Designs. Permission to copy or revise this drawing can only be obtained thru a written agreement w/ Sign Designs. See your sales representative or call Sign Designs.


By signing this drawing document, I understand that I am not obligated to purchase this project, notwithstanding, the above artwork cannot be submitted for pricing, duplication and/or manufacturing to another sign company, architectural company or other business entity for the purpose or intent of manufacturing or for use as intellectual property, such as, but not limited to, a company logo, unless the represented logo was provided to Sign Designs by the customer and input into this drawing document by a Sign Designs employee.

7 OF 13


SIGN D: EXISTING INDIRECTLY ILLUMINATED HIGH RISE SIGN

SCOPE OF WORK: RECEIVE AND INSTALL NEW FACES & CABINET FOR EXISTING HIGH RISE POLES
60 SQUARE FEET
CABINET: (1) 12'-0" X 5'-0" OVERALL SIZE W/ FLEX FACES
MOUNTING: 3" X 3" SQ TUBE MOUNTED TO EXISTING BRACKETS W/ (2) 4" X 0.5" BOLTS PER BRACKET
ILLUMINATION: INDIRECTLY ILLUMINATED USING GOOSENECK LAMPS
FINISH: PAINT POLES WHITE
NOTE: HOOK TO ELECTRICAL SUPPLIED BY OTHERS
REMOVAL: REMOVE EXISTING "PRODUCE" SIGN CABINET AND SAVE

SIGN TO BE INDIRECTLY ILLUMINATED BY GOOSENECK LAMPS THAT WILL BE PROVIDED BY OTHERS

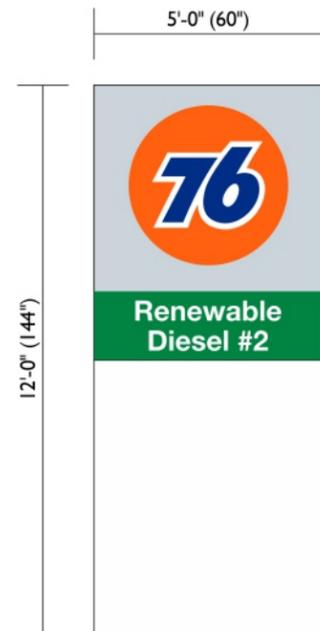

*PLACEHOLDER ONLY / APPROXIMATE LAYOUT
 EXACT COLORS, FONT AND LAYOUT BY OTHERS

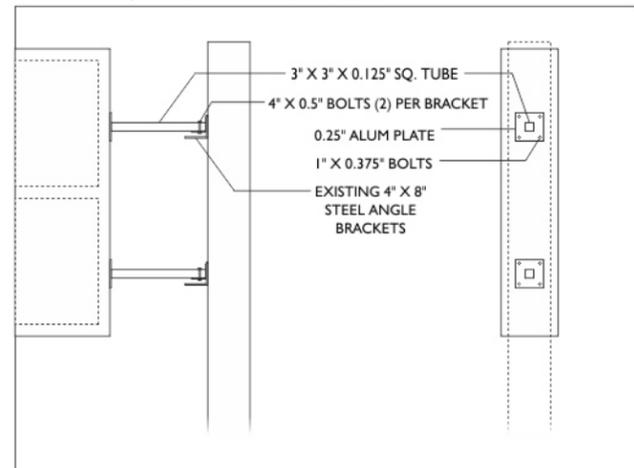

05.05.21 R19 VT: REVERT ILLUMINATION TO GOOSENECK LAMPS FOR SIGNS A, D & K. REVERT SIGN C TO R15 VERSION. ALL PER JEFF STOCKTON. NO OTHER CHANGES. 04.18.21 R18 VT: CHANGE SIGN D TO 12X5; ADD "REMOVED BY OTHERS" TO SIGN C. CABINET PER JEFF STOCKTON. NO OTHER CHANGES. 04.13.21 R17 VT: CHANGE SIGN D TO 6X5; CABINET PER JEFF STOCKTON. NO OTHER CHANGES. 02.18.21 R16 VT: REMOVE ALL GOOSENECK LAMPS AND REVERT TO LEDS; REVERT SIGN C TO OLD MONUMENT FROM R2. ALL PER JEFF STOCKTON. NO OTHER CHANGES. 01.19.21 R15 VT: REVERT CANOPY SIGNS A PER JEFF STOCKTON. NO OTHER CHANGES. 01.19.21 R14 VT: REMOVE "X" FROM TWIN POLE SIGN ON PHOTO (PG 12) PER STEVE LOCKE. NO OTHER CHANGES. 01.14.21 R13 VT: UPDATE ADDRESS AND UPDATE SIGN L TO 7337. PER JEFF STOCKTON. NO OTHER CHANGES. 01.12.21 R12 VT: VARIOUS REDLINE CHANGES PER STEVE LOCKE; JEFF STOCKTON. ADD SIGN L (PVC ADDRESS NUMERALS); REVISE SIGN K TO "STARS" CONVENIENCE STORE PER JEFF STOCKTON/CUSTOMER. 12.23.20 R10 VT: ADD GOOSENECK LAMPS TO SIGNS A,D & K. REPLACE SIGN C WITH NEW MONUMENT SIGN. ADD VARIOUS MEASUREMENTS TO EXISTING SIGN PHOTOS ALL PER JEFF STOCKTON. NO OTHER CHANGES. 10.19.20 R10 VT: MARK POLE SIGNS ARE "REMOVED" ON PG 11 PER STEVE LOCKE. NO OTHER CHANGES. 09.03.20 R9 VT: REVISE SIGN C NEW POLE & FOOTING PER JEFF STOCKTON. NO OTHER CHANGES. 08.24.20 R1 VT: ADD PHOTOS OF EXISTING SIGNS TO BE REMOVED PER JEFF STOCKTON. NO OTHER CHANGES. 08.12.20 R7 VT: CHANGE SIGN C OAH TO 19'-6" PER JEFF STOCKTON. NO OTHER CHANGES. 08.07.20 R6 VT: ADD VARIOUS MEASUREMENTS. UPDATE SIGN C MOUNTING DETAIL. ADD STAMPED ENGINEERING PAGE. ALL PER JEFF STOCKTON. NO OTHER CHANGES. 08.06.20 R5 VT: UPDATE SITE MAP PER JEFF STOCKTON. NO OTHER CHANGES. 07.28.20 R4 VT: SIGN D-SWAP DIESEL #2 AND 24 HOURS FACES. SIGN K- SWAP COLOR SCHEME ON BACKER PANEL PER JEFF STOCKTON/CUSTOMER. NO OTHER CHANGES. 07.10.20 R3 VT: REMOVE SIGN L. CHANGE SIGN K TO "A CONVENIENCE STORE" PANS ON BACKER. ADD MOUNTING DETAILS TO SIGN D. CHANGE SIGN C LEDS TO WHITE. ALL PER JEFF STOCKTON. NO OTHER CHANGES. 06.02.20 R2 VT: PUT SIGN C ON POLE. SHOW SIGN D AS HORIZ LAYOUT AND WRONG PROPORTIONS PER JEFF STOCKTON. UPDATE PHOTO FOR SIGN K/L. ALL PER JEFF STOCKTON. NO OTHER CHANGES. 05.26.20 R1 VT: REVISE SIGN D OAH SIZE TO 8' X 5'; ADD SIGNS K & L. ALL PER JEFF STOCKTON.

PERMIT DRAWING

SDI SIGN DESIGNS
 INCORPORATED
 PO Box 4590 | 204 Campus Way Modesto Ca 95350 | O 209.524.4484 | F 209.521.0272 | Ca LIC#268001 | C-45 | Nv Lic#0082570 | C-6

MEMBER
 SA California Sign Association
 WSA
 ISA INTERNATIONAL SIGN ASSOCIATION

NOTICE TO THE CUSTOMER
 Note: The colors depicted on this rendering may not match actual colors used on the finished display. Please refer to the detail drawing for the approved color specifications. Note: The cost of providing electrical wiring to the sign area, all required permits and all special inspections are not included in this sign proposal. Note: The proportion of signs shown on building & landscape area photos is an approximate representation.

CUSTOMER APPROVAL

ACCEPTED W/ NO CHANGES ACCEPTED W/ CHANGES AS NOTED
 REVISE AS NOTED AND RESUBMIT

BY CUSTOMER BY LANDLORD
 DATE _____ DATE _____

DATE	BY	DATE	BY
05.05.20	VT	12.23.20	VT
05.26.20	VT	01.12.21	VT
06.02.20	VT	01.14.21	VT
07.10.20	VT	01.19.21	VT
07.28.20	VT	01.19.21	VT
08.06.20	VT	02.18.21	VT
08.07.20	VT	04.13.21	VT
08.24.20	VT	04.18.21	VT
09.03.20	VT	05.05.21	VT
10.19.20	VT		

COMPANY OR JOB NAME / JOB DESCRIPTION **200337 R19**

76 SIGN PROGRAM

ADDRESS: **7337 ODAY ROAD VACAVILLE CALIFORNIA 95688**

SALESPERSON: **JEFF STOCKTON** CUSTOMER CONTACT: **XXXXXX**

© COPYRIGHT 2021

This drawing was created to assist you in visualizing our proposal. The original ideas herein are the property of Sign Designs. Permission to copy or revise this drawing can only be obtained thru a written agreement w/ Sign Designs. See your sales representative or call Sign Designs.

By signing this drawing document, I understand that I am not obligated to purchase this project, notwithstanding, the above artwork cannot be submitted for pricing, duplication and/or manufacturing to another sign company, architectural company or other business entity for the purpose or intent of manufacturing or for use as intellectual property, such as, but not limited to, a company logo, unless the represented logo was provided to Sign Designs by the customer and input into this drawing document by a Sign Designs employee.

NAME / DATE **8 OF 13**


This sign is intended to be installed in accordance with the requirements of ARTICLE 600 of the national electrical code &/or other applicable codes. this includes proper grounding & bonding of the sign. The location of the disconnect switch after installation shall comply w/ ARTICLE 600.6(A)(1) of the National Electrical Code. All measures shown in this drawing are nominal until the "NOT FOR PRODUCTION" is removed

UNDER CANOPY ITEMS


SCOPE OF WORK: RECEIVE AND INSTALL NEW UNDER CANOPY ITEMS
REMOVAL: NONE

SIGNS

- E1-E4:** RECEIVE AND INSTALL (4) NEW FUEL PUMP VALANCES
- F1-F4:** RECEIVE AND INSTALL (4) NEW FUEL PUMP TOPPERS
- G1-G2:** RECEIVE AND INSTALL (2) NEW CANOPY CLEARANCE VINYL TO CANOPY FASCIA
- H1-H4:** RECEIVE AND INSTALL (4) COLUMN CLADDING
- i1-i4:** RECEIVE AND INSTALL (4) NEW PUMP ID FLAGS
- J1-J4:** RECEIVE AND INSTALL (4) AMENITY BINS AT EACH PUMP ISLAND

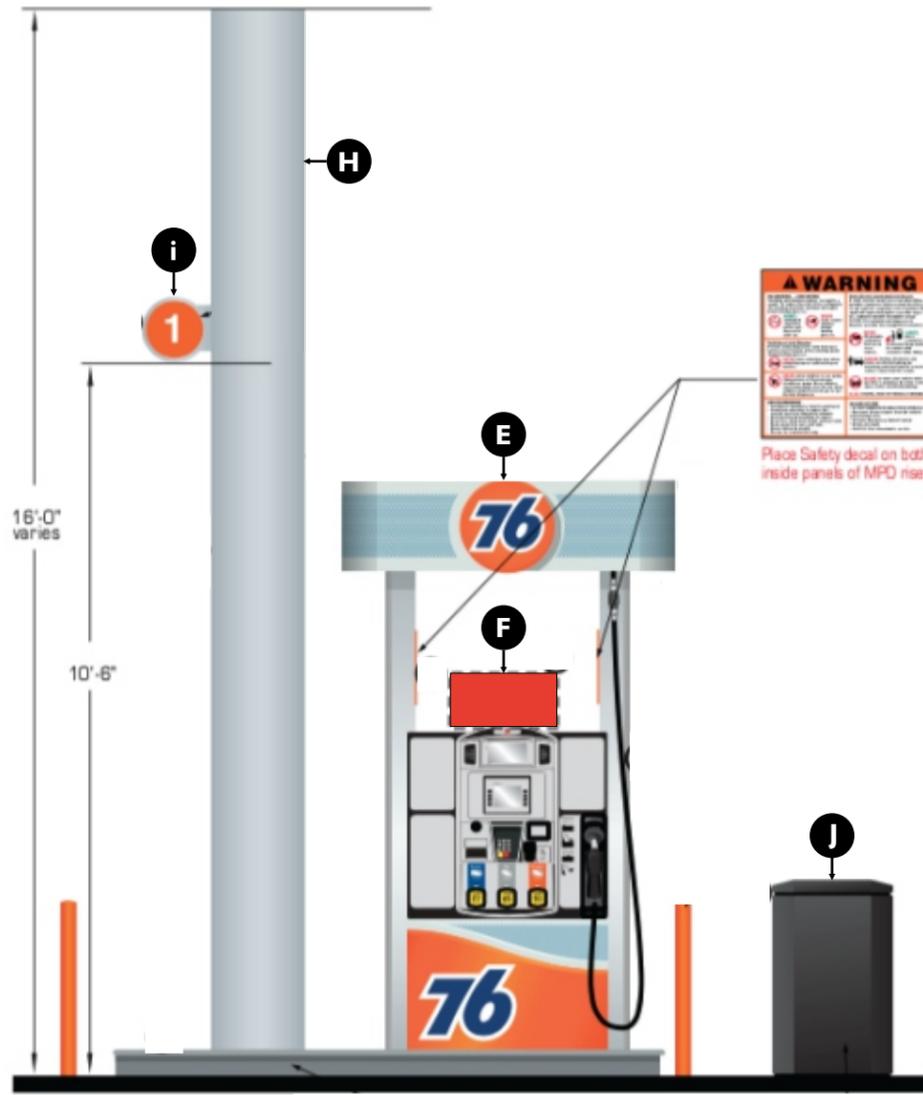

A Typical Pump Island Elevation

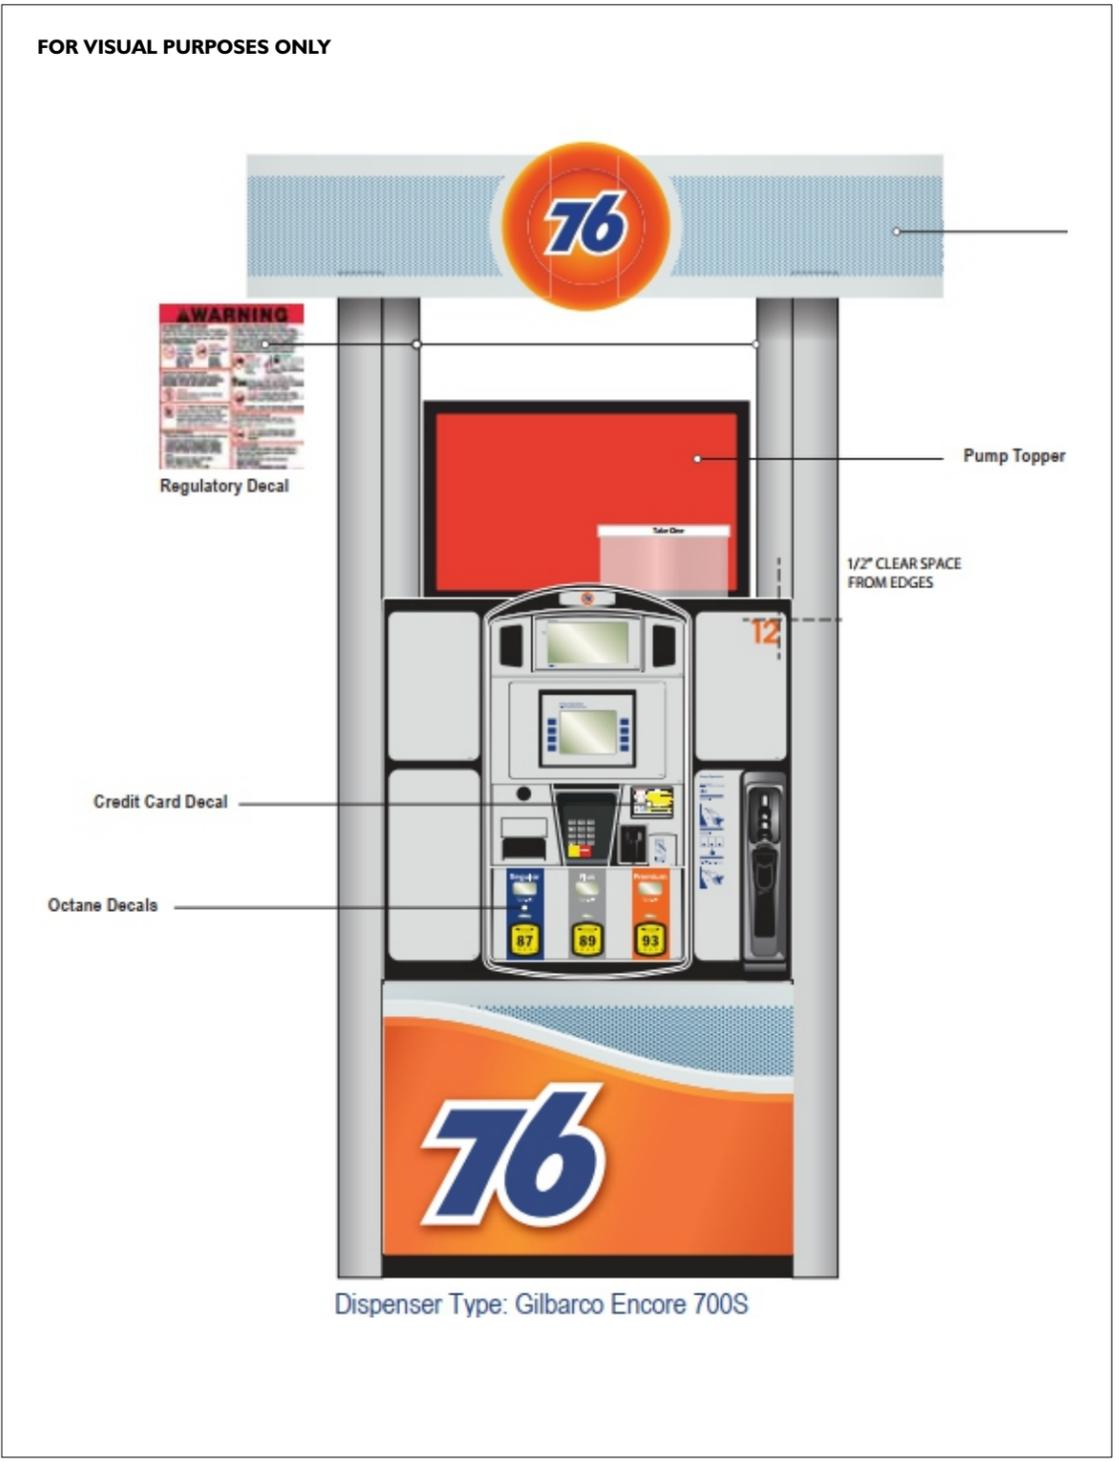

Dispenser Type: Gilbarco Encore 700S

05.05.21 R19 VT: REVERT ILLUMINATION TO GOOSENECK LAMPS FOR SIGNS A, D & K. REVERT SIGN C TO R15 VERSION. ALL PER JEFF STOCKTON, NO OTHER CHANGES. 04.18.21 R18 VT: CHANGE SIGN D TO 12X5; ADD "REMOVED BY OTHERS" TO SIGN C, CABINET PER JEFF STOCKTON, NO OTHER CHANGES. 04.13.21 R17 VT: CHANGE SIGN D TO 6X5; CABINET PER JEFF STOCKTON, NO OTHER CHANGES. 02.18.21 R16 VT: REMOVE ALL GOOSENECK LAMPS AND REVERT TO LEDS; REVERT SIGN C TO OLD MONUMENT FROM R2. ALL PER JEFF STOCKTON, NO OTHER CHANGES. 01.19.21 R15 VT: REVERT CANOPY SIGNS A PER JEFF STOCKTON, NO OTHER CHANGES. 01.19.21 R14 VT: REMOVE "X" FROM TWIN POLE SIGN ON PHOTO (PG 12) PER STEVE LOCKE, NO OTHER CHANGES. 01.14.21 R13 VT: UPDATE ADDRESS AND UPDATE SIGN L TO 7337. PER JEFF STOCKTON, NO OTHER CHANGES. 01.12.21 R12 VT: VARIOUS REDLINE CHANGES PER STEVE LOCKE, JEFF STOCKTON, ADD SIGN L (PVC ADDRESS NUMERALS), REVISE SIGN K TO "STARS" CONVENIENCE STORE PER JEFF STOCKTON/CUSTOMER. 12.23.20 R10 VT: ADD GOOSENECK LAMPS TO SIGNS A, D & K, REPLACE SIGN C WITH NEW MONUMENT SIGN, ADD VARIOUS MEASUREMENTS TO EXISTING SIGN PHOTOS ALL PER JEFF STOCKTON, NO OTHER CHANGES. 10.19.20 R10 VT: MARK POLE SIGNS ARE "REMOVED" ON PG 11 PER STEVE LOCKE, NO OTHER CHANGES. 09.03.20 R9 VT: REVISE SIGN C NEW POLE & FOOTING PER JEFF STOCKTON, NO OTHER CHANGES. 08.24.20 R1 VT: ADD PHOTOS OF EXISTING SIGNS TO BE REMOVED PER JEFF STOCKTON, NO OTHER CHANGES. 08.12.20 R7 VT: CHANGE SIGN C OAH TO 19'-6" PER JEFF STOCKTON, NO OTHER CHANGES. 08.07.20 R6 VT: ADD VARIOUS MEASUREMENTS, UPDATE SIGN C MOUNTING DETAIL, ADD STAMPED ENGINEERING PAGE, ALL PER JEFF STOCKTON, NO OTHER CHANGES. 08.06.20 R5 VT: UPDATE SITE MAP PER JEFF STOCKTON, NO OTHER CHANGES. 07.28.20 R4 VT: SIGN D-SWAP DIESEL #2 AND 24 HOURS FACES, SIGN K- SWAP COLOR SCHEME ON BACKER PANEL PER JEFF STOCKTON/CUSTOMER, NO OTHER CHANGES. 07.10.20 R3 VT: REMOVE SIGN L, CHANGE SIGN K TO "A CONVENIENCE STORE" PANS ON BACKER, ADD MOUNTING DETAILS TO SIGN D, CHANGE SIGN C LEDS TO WHITE, ALL PER JEFF STOCKTON, NO OTHER CHANGES. 06.02.20 R2 VT: PUT SIGN C ON POLE, SHOW SIGN D AS HORIZ LAYOUT AND WRONG PROPORTIONS PER JEFF STOCKTON, UPDATE PHOTO FOR SIGN K/L, ALL PER JEFF STOCKTON, NO OTHER CHANGES. 05.26.20 R1 VT: REVISE SIGN D OAH SIZE TO 8' X 5', ADD SIGNS K & L, ALL PER JEFF STOCKTON.

PERMIT DRAWING 200337 R19 / 9 OF 13

MEMBER
 SA California Sign Association
 WSA
 ISA INTERNATIONAL SIGN ASSOCIATION

NOTICE TO THE CUSTOMER
 Note: The colors depicted on this rendering may not match actual colors used on the finished display. Please refer to the detail drawing for the approved color specifications. Note: The cost of providing electrical wiring to the sign area, all required permits and all special inspections are not included in this sign proposal. Note: The proportion of signs shown on building & landscape area photos is an approximate representation.

CUSTOMER APPROVAL

ACCEPTED W/ NO CHANGES ACCEPTED W/ CHANGES AS NOTED
 REVISE AS NOTED AND RESUBMIT

BY CUSTOMER BY LANDLORD
 DATE _____ DATE _____

DATE	BY	DATE	BY
05.05.20	VT	12.23.20	VT
05.26.20	VT	01.12.21	VT
06.02.20	VT	01.14.21	VT
07.10.20	VT	01.19.21	VT
07.28.20	VT	01.19.21	VT
08.06.20	VT	02.18.21	VT
08.07.20	VT	04.13.21	VT
08.24.20	VT	04.18.21	VT
09.03.20	VT	05.05.21	VT
10.19.20	VT		

COMPANY OR JOB NAME / JOB DESCRIPTION **200337 R19**

76 SIGN PROGRAM

ADDRESS: **7337 ODAY ROAD VACAVILLE CALIFORNIA 95688**

SALESPERSON: **JEFF STOCKTON** CUSTOMER CONTACT: **XXXXXX**

NAME / DATE

© COPYRIGHT 2021

This drawing was created to assist you in visualizing our proposal. The original ideas herein are the property of Sign Designs. Permission to copy or revise this drawing can only be obtained thru a written agreement w/ Sign Designs. See your sales representative or call Sign Designs.

By signing this drawing document, I understand that I am not obligated to purchase this project, notwithstanding, the above artwork cannot be submitted for pricing, duplication and/or manufacturing to another sign company, architectural company or other business entity for the purpose or intent of manufacturing or for use as intellectual property, such as, but not limited to, a company logo, unless the represented logo was provided to Sign Designs by the customer and input into this drawing document by a Sign Designs employee.




SIGN K: INDIRECTLY ILLUMINATED PAN CHANNEL LETTERS ON BACKER PANEL

0.5" = 1'-0"
FACES: 0.188" WHITE ACRYLIC W/ FIRST SURFACE VINYL DECORATION
VINYL: EXTERIOR GRADE DIGITAL PRINT W/ SATIN UV LAMINATE
RETURNS: PRE PAINTED 3" BLACK ALUM **TRIM CAP:** 0.75" BLACK **LETTERBACKS:** PER PAINTED WHITE ALUM
ILLUMINATION: GOOSENECK LAMPS **BACKER PANEL:** 0.25" ALUM W/ FIRST SURFACE VINYL DECORATION
VINYL: 3630-22 BLACK, 3630-20 WHITE, 3630-59 DARK BROWN, 3630-44 ORANGE
FINISH: (BACKER PANEL) PAINTED WHITE, SATIN, NO TEXTURE
MOUNTING: FLUSH TO WALL USING THRU BOLTS OR BEST METHOD.
WALL TYPE: _____ **REMOVAL:** _____
NOTE: GOOSENECK LIGHTING MAY CAST SEVERE SHADOWS
NOTE: THERE HAS NOT BEEN AN OFFICIAL SURVEY AS OF 07.10.20

QTY: (1) / 50 SQ. FT.

SCOPE OF WORK: FABRICATE AND INSTALL (1) INDIRECTLY ILLUMINATED PAN CHANNEL LETTERS ON BACKER PANEL

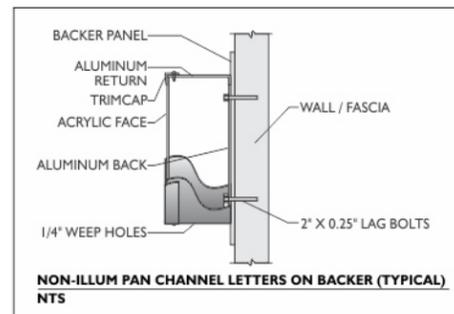

NON-ILLUM PAN CHANNEL LETTERS ON BACKER (TYPICAL) NTS

05.05.21 R19 VT: REVERT ILLUMINATION TO GOOSENECK LAMPS FOR SIGNS A, D & K. REVERT SIGN C TO R15 VERSION, ALL PER JEFF STOCKTON, NO OTHER CHANGES. 04.18.21 R18 VT: CHANGE SIGN D TO 12X5; ADD "REMOVED BY OTHERS" TO SIGN C, CABINET PER JEFF STOCKTON, NO OTHER CHANGES. 04.13.21 R17 VT: CHANGE SIGN D TO 6X5; CABINET PER JEFF STOCKTON, NO OTHER CHANGES. 02.18.21 R16 VT: REMOVE ALL GOOSENECK LAMPS AND REVERT TO LEDS, REVERT SIGN C TO OLD MONUMENT FROM R2, ALL PER JEFF STOCKTON, NO OTHER CHANGES. 01.19.21 R15 VT: REVERT CANOPY SIGNS A PER JEFF STOCKTON, NO OTHER CHANGES. 01.19.21 R14 VT: REMOVE "X" FROM TWIN POLE SIGN ON PHOTO (PG 12) PER STEVE LOCKE, NO OTHER CHANGES. 01.14.21 R13 VT: UPDATE ADDRESS AND UPDATE SIGN L TO 7337, PER JEFF STOCKTON, NO OTHER CHANGES. 01.12.21 R12 VT: VARIOUS REDLINE CHANGES PER STEVE LOCKE, JEFF STOCKTON, ADD SIGN L (PVC ADDRESS NUMERALS), REVISE SIGN K TO "STARS" CONVENIENCE STORE PER JEFF STOCKTON/CUSTOMER, 12.23.20 R10 VT: ADD GOOSENECK LAMPS TO SIGNS A, D & K, REPLACE SIGN C WITH NEW MONUMENT SIGN, ADD VARIOUS MEASUREMENTS TO EXISTING SIGN PHOTOS ALL PER JEFF STOCKTON, NO OTHER CHANGES. 10.19.20 R10 VT: MARK POLE SIGNS ARE "REMOVED" ON PG 11 PER STEVE LOCKE, NO OTHER CHANGES. 09.03.20 R9 VT: REVISE SIGN C NEW POLE & FOOTING PER JEFF STOCKTON, NO OTHER CHANGES. 08.24.20 R1 VT: ADD PHOTOS OF EXISTING SIGNS TO BE REMOVED PER JEFF STOCKTON, NO OTHER CHANGES. 08.12.20 R7 VT: CHANGE SIGN C OAH TO 19'-6" PER JEFF STOCKTON, NO OTHER CHANGES. 08.07.20 R6 VT: ADD VARIOUS MEASUREMENTS, UPDATE SIGN C MOUNTING DETAIL, ADD STAMPED ENGINEERING PAGE, ALL PER JEFF STOCKTON, NO OTHER CHANGES. 08.06.20 R5 VT: UPDATE SITE MAP PER JEFF STOCKTON, NO OTHER CHANGES. 07.28.20 R4 VT: SIGN D-SWAP DIESEL #2 AND 24 HOURS FACES, SIGN K- SWAP COLOR SCHEME ON BACKER PANEL PER JEFF STOCKTON/CUSTOMER, NO OTHER CHANGES. 07.10.20 R3 VT: REMOVE SIGN L, CHANGE SIGN K TO "A CONVENIENCE STORE" PANS ON BACKER, ADD MOUNTING DETAILS TO SIGN D, CHANGE SIGN C LEDS TO WHITE, ALL PER JEFF STOCKTON, NO OTHER CHANGES. 06.02.20 R2 VT: PUT SIGN C ON POLE, SHOW SIGN D AS HORZ LAYOUT AND WRONG PROPORTIONS PER JEFF STOCKTON, UPDATE PHOTO FOR SIGN K/L, ALL PER JEFF STOCKTON, NO OTHER CHANGES. 05.26.20 R1 VT: REVISE SIGN D OAH SIZE TO 8' X 5', ADD SIGNS K & L, ALL PER JEFF STOCKTON.

PERMIT DRAWING

200337 R19 / 10 OF 13



PO Box 4590 | 204 Campus Way Modesto Ca 95350 | O 209.524.4484 | F 209.521.0272 | Ca LIC#268001 | C-45 | Nv Lic#0082570 | C-6



NOTICE TO THE CUSTOMER

Note: The colors depicted on this rendering may not match actual colors used on the finished display. Please refer to the detail drawing for the approved color specifications. Note: The cost of providing electrical wiring to the sign area, all required permits and all special inspections are not included in this sign proposal. Note: The proportion of signs shown on building & landscape area photos is an approximate representation.

CUSTOMER APPROVAL

ACCEPTED W/ NO CHANGES ACCEPTED W/ CHANGES AS NOTED
 REVISE AS NOTED AND RESUBMIT

BY _____ CUSTOMER BY _____ LANDLORD
DATE _____ DATE _____

DATE	BY	DATE	BY
05.05.20	VT	12.23.20	VT
05.26.20	VT	01.12.21	VT
06.02.20	VT	01.14.21	VT
07.10.20	VT	01.19.21	VT
07.28.20	VT	01.19.21	VT
08.06.20	VT	02.18.21	VT
08.07.20	VT	04.13.21	VT
08.24.20	VT	04.18.21	VT
09.03.20	VT	05.05.21	VT
10.19.20	VT		

COMPANY OR JOB NAME / JOB DESCRIPTION		200337 R19
76 SIGN PROGRAM		
ADDRESS:	7337 ODAY ROAD VACAVILLE CALIFORNIA 95688	
SALESPERSON:	JEFF STOCKTON	
CUSTOMER CONTACT:	XXXXXX	


© 2021

This drawing was created to assist you in visualizing our proposal. The original ideas herein are the property of Sign Designs. Permission to copy or revise this drawing can only be obtained thru a written agreement w/ Sign Designs. See your sales representative or call Sign Designs.

By signing this drawing document, I understand that I am not obligated to purchase this project, notwithstanding, the above artwork cannot be submitted for pricing, duplication and/or manufacturing to another sign company, architectural company or other business entity for the purpose or intent of manufacturing or for use as intellectual property, such as, but not limited to, a company logo, unless the represented logo was provided to Sign Designs by the customer and input into this drawing document by a Sign Designs employee.

NAME / DATE

10 OF 13

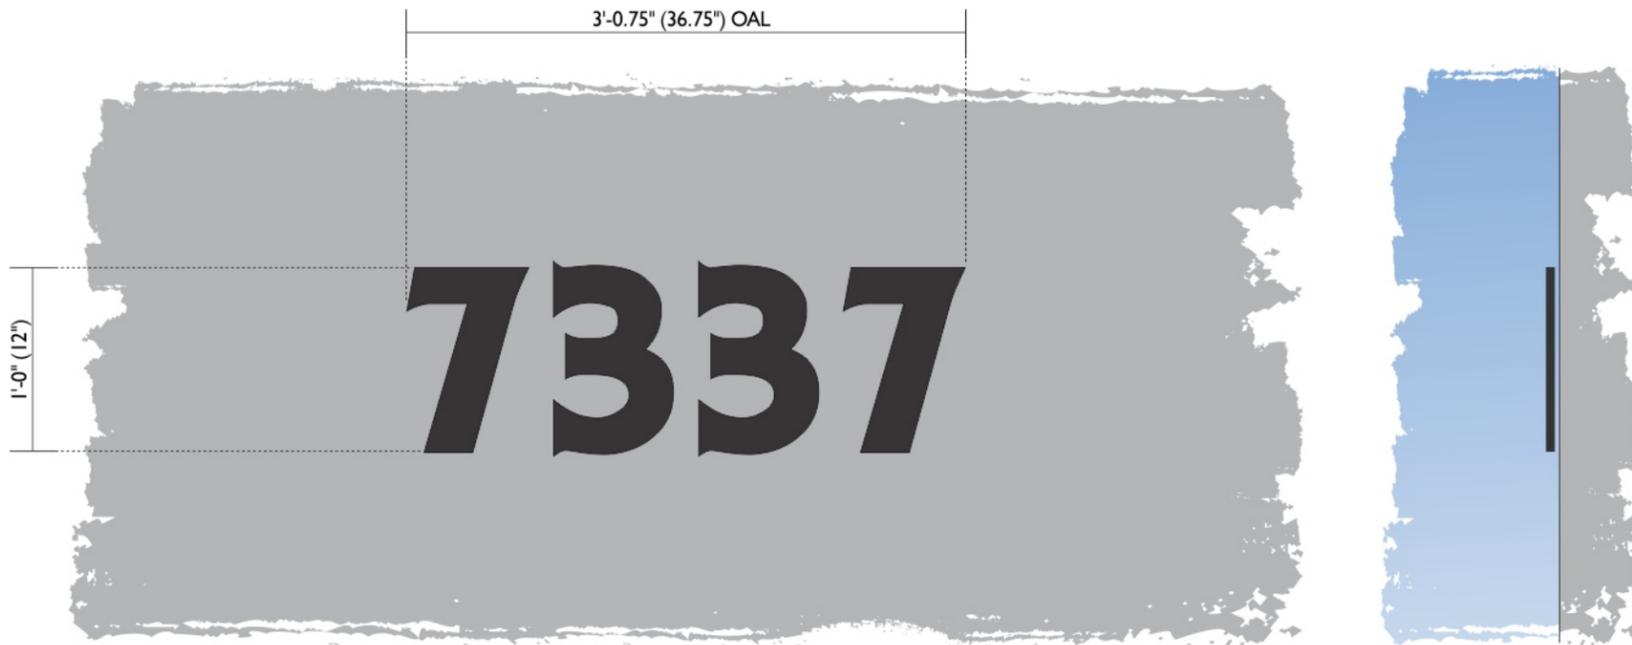

SIGN L: NON ILLUMINATED FLAT CUT OUT LETTERS

1"=1'-0"


SUBSTRATE: 0.5" DEEP OPAQUE BLACK ACRYLIC **MOUNTING:** FLUSH TO WALL USING STUDS OR BEST METHOD.

WALL TYPE: _____ **REMOVAL:** _____

NOTE: THERE HAS NOT BEEN AN OFFICIAL SURVEY AS OF 07.10.20

QTY: (1) / 3 SQ. FT.

SCOPE OF WORK: FABRICATE AND INSTALL (1) SET OF NON ILLUMINATED FLAT CUT OUT LETTERS

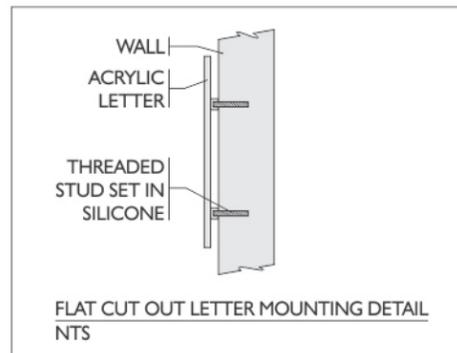

05.05.21 R19 VT: REVERT ILLUMINATION TO GOOSENECK LAMPS FOR SIGNS A, D & K. REVERT SIGN C TO R15 VERSION. ALL PER JEFF STOCKTON. NO OTHER CHANGES. 04.18.21 R18 VT: CHANGE SIGN D TO 12X5; ADD "REMOVED BY OTHERS" TO SIGN C. CABINET PER JEFF STOCKTON. NO OTHER CHANGES. 04.13.21 R17 VT: CHANGE SIGN D TO 6X5; CABINET PER JEFF STOCKTON. NO OTHER CHANGES. 02.18.21 R16 VT: REMOVE ALL GOOSENECK LAMPS AND REVERT TO LEDS; REVERT SIGN C TO OLD MONUMENT FROM R2. ALL PER JEFF STOCKTON. NO OTHER CHANGES. 01.19.21 R15 VT: REVERT CANOPY SIGNS A PER JEFF STOCKTON. NO OTHER CHANGES. 01.19.21 R14 VT: REMOVE "X" FROM TWIN POLE SIGN ON PHOTO (PG 12) PER STEVE LOCKE. NO OTHER CHANGES. 01.14.21 R13 VT: UPDATE ADDRESS AND UPDATE SIGN L TO 7337. PER JEFF STOCKTON. NO OTHER CHANGES. 01.12.21 R12 VT: VARIOUS REDLINE CHANGES PER STEVE LOCKE; JEFF STOCKTON. ADD SIGN L (PVC ADDRESS NUMERALS); REVISE SIGN K TO "STARS" CONVENIENCE STORE PER JEFF STOCKTON/CUSTOMER. 12.23.20 R10 VT: ADD GOOSENECK LAMPS TO SIGNS A,D & K. REPLACE SIGN C WITH NEW MONUMENT SIGN. ADD VARIOUS MEASUREMENTS TO EXISTING SIGN PHOTOS ALL PER JEFF STOCKTON. NO OTHER CHANGES. 10.19.20 R10 VT: MARK POLE SIGNS ARE "REMOVED" ON PG 11 PER STEVE LOCKE. NO OTHER CHANGES. 09.03.20 R9 VT: REVISE SIGN C NEW POLE & FOOTING PER JEFF STOCKTON. NO OTHER CHANGES. 08.24.20 R1 VT: ADD PHOTOS OF EXISTING SIGNS TO BE REMOVED PER JEFF STOCKTON. NO OTHER CHANGES. 08.12.20 R7 VT: CHANGE SIGN C OAH TO 19'-6" PER JEFF STOCKTON. NO OTHER CHANGES. 08.07.20 R6 VT: ADD VARIOUS MEASUREMENTS. UPDATE SIGN C MOUNTING DETAIL. ADD STAMPED ENGINEERING PAGE. ALL PER JEFF STOCKTON. NO OTHER CHANGES. 08.06.20 R5 VT: UPDATE SITE MAP PER JEFF STOCKTON. NO OTHER CHANGES. 07.28.20 R4 VT: SIGN D-SWAP DIESEL #2 AND 24 HOURS FACES. SIGN K- SWAP COLOR SCHEME ON BACKER PANEL PER JEFF STOCKTON/CUSTOMER. NO OTHER CHANGES. 07.10.20 R3 VT: REMOVE SIGN L. CHANGE SIGN K TO "A CONVENIENCE STORE" PANS ON BACKER. ADD MOUNTING DETAILS TO SIGN D. CHANGE SIGN C LEDS TO WHITE. ALL PER JEFF STOCKTON. NO OTHER CHANGES. 06.02.20 R2 VT: PUT SIGN C ON POLE. SHOW SIGN D AS HORIZ LAYOUT AND WRONG PROPORTIONS PER JEFF STOCKTON. UPDATE PHOTO FOR SIGN K/L. ALL PER JEFF STOCKTON. NO OTHER CHANGES. 05.26.20 R1 VT: REVISE SIGN D OA SIZE TO 8' X 5'; ADD SIGNS K & L. ALL PER JEFF STOCKTON.

PERMIT DRAWING

200337 R19 / 11 OF 13



PO Box 4590 | 204 Campus Way Modesto Ca 95350 | O 209.524.4484 | F 209.521.0272 | Ca LIC#268001 | C-45 | Nv Lic#0082570 | C-6



NOTICE TO THE CUSTOMER

Note: The colors depicted on this rendering may not match actual colors used on the finished display. Please refer to the detail drawing for the approved color specifications. Note: The cost of providing electrical wiring to the sign area, all required permits and all special inspections are not included in this sign proposal. Note: The proportion of signs shown on building & landscape area photos is an approximate representation.

CUSTOMER APPROVAL

ACCEPTED W/ NO CHANGES ACCEPTED W/ CHANGES AS NOTED
 REVISE AS NOTED AND RESUBMIT

BY _____ CUSTOMER BY _____ LANDLORD
DATE _____ DATE _____

DATE	BY	DATE	BY
05.05.20	VT	12.23.20	VT
05.26.20	VT	01.12.21	VT
06.02.20	VT	01.14.21	VT
07.10.20	VT	01.19.21	VT
07.28.20	VT	01.19.21	VT
08.06.20	VT	02.18.21	VT
08.07.20	VT	04.13.21	VT
08.24.20	VT	04.18.21	VT
09.03.20	VT	05.05.21	VT
10.19.20	VT		

COMPANY OR JOB NAME / JOB DESCRIPTION

200337 R19

76
SIGN PROGRAM

ADDRESS: **7337 ODAY ROAD VACAVILLE CALIFORNIA 95688**

SALESPERSON: **JEFF STOCKTON** CUSTOMER CONTACT: **XXXXXX**

© COPYRIGHT 2021

This drawing was created to assist you in visualizing our proposal. The original ideas herein are the property of Sign Designs. Permission to copy or revise this drawing can only be obtained thru a written agreement w/ Sign Designs. See your sales representative or call Sign Designs.

By signing this drawing document, I understand that I am not obligated to purchase this project, notwithstanding, the above artwork cannot be submitted for pricing, duplication and/or manufacturing to another sign company, architectural company or other business entity for the purpose or intent of manufacturing or for use as intellectual property, such as, but not limited to, a company logo, unless the represented logo was provided to Sign Designs by the customer and input into this drawing document by a Sign Designs employee.

NAME / DATE

11 OF 13

This sign is intended to be installed in accordance with the requirements of ARTICLE 600 of the national electrical code &/or other applicable codes. this includes proper grounding & bonding of the sign. The location of the disconnect switch after installation shall comply w/ ARTICLE 600.6(A)(1) of the National Electrical Code. All measures shown in this drawing are nominal until the "NOT FOR PRODUCTION" is removed



ITEMS MARKED OUT WITH RED SHALL BE REMOVED

05.05.21 R19 VT: REVERT ILLUMINATION TO GOOSENECK LAMPS FOR SIGNS A, D & K. REVERT SIGN C TO R15 VERSION. ALL PER JEFF STOCKTON, NO OTHER CHANGES. 04.18.21 R18 VT: CHANGE SIGN D TO 12X5; ADD "REMOVED BY OTHERS" TO SIGN C, CABINET PER JEFF STOCKTON, NO OTHER CHANGES. 04.13.21 R17 VT: CHANGE SIGN D TO 6X5; CABINET PER JEFF STOCKTON, NO OTHER CHANGES. 02.18.21 R16 VT: REMOVE ALL GOOSENECK LAMPS AND REVERT TO LEDS; REVERT SIGN C TO OLD MONUMENT FROM R2. ALL PER JEFF STOCKTON, NO OTHER CHANGES. 01.19.21 R15 VT: REVERT CANOPY SIGNS A PER JEFF STOCKTON, NO OTHER CHANGES. 01.19.21 R14 VT: REMOVE "X" FROM TWIN POLE SIGN ON PHOTO (PG 12) PER STEVE LOCKE, NO OTHER CHANGES. 01.14.21 R13 VT: UPDATE ADDRESS AND UPDATE SIGN L TO 7337. PER JEFF STOCKTON, NO OTHER CHANGES. 01.12.21 R12 VT: VARIOUS REDLINE CHANGES PER STEVE LOCKE, JEFF STOCKTON, ADD SIGN L (PVC ADDRESS NUMERALS), REVISE SIGN K TO "STARS" CONVENIENCE STORE PER JEFF STOCKTON/CUSTOMER. 12.23.20 R10 VT: ADD GOOSENECK LAMPS TO SIGNS A,D & K, REPLACE SIGN C WITH NEW MONUMENT SIGN, ADD VARIOUS MEASUREMENTS TO EXISTING SIGN PHOTOS ALL PER JEFF STOCKTON, NO OTHER CHANGES. 10.19.20 R10 VT: MARK POLE SIGNS ARE "REMOVED" ON PG 11 PER STEVE LOCKE, NO OTHER CHANGES. 09.03.20 R9 VT: REVISE SIGN C NEW POLE & FOOTING PER JEFF STOCKTON, NO OTHER CHANGES. 08.24.20 R1 VT: ADD PHOTOS OF EXISTING SIGNS TO BE REMOVED PER JEFF STOCKTON, NO OTHER CHANGES. 08.12.20 R7 VT: CHANGE SIGN C OAH TO 19'-6" PER JEFF STOCKTON, NO OTHER CHANGES. 08.07.20 R6 VT: ADD VARIOUS MEASUREMENTS, UPDATE SIGN C MOUNTING DETAIL, ADD STAMPED ENGINEERING PAGE, ALL PER JEFF STOCKTON, NO OTHER CHANGES. 08.06.20 R5 VT: UPDATE SITE MAP PER JEFF STOCKTON, NO OTHER CHANGES. 07.28.20 R4 VT: SIGN D-SWAP DIESEL #2 AND 24 HOURS FACES, SIGN K- SWAP COLOR SCHEME ON BACKER PANEL PER JEFF STOCKTON/CUSTOMER, NO OTHER CHANGES. 07.10.20 R3 VT: REMOVE SIGN L, CHANGE SIGN K TO "A CONVENIENCE STORE" PANS ON BACKER, ADD MOUNTING DETAILS TO SIGN D, CHANGE SIGN C LEDS TO WHITE, ALL PER JEFF STOCKTON, NO OTHER CHANGES. 06.02.20 R2 VT: PUT SIGN C ON POLE, SHOW SIGN D AS HORIZ LAYOUT AND WRONG PROPORTIONS PER JEFF STOCKTON, UPDATE PHOTO FOR SIGN K/L, ALL PER JEFF STOCKTON, NO OTHER CHANGES. 05.26.20 R1 VT: REVISE SIGN D OAH SIZE TO 8' X 5'; ADD SIGNS K & L, ALL PER JEFF STOCKTON.

200337 R19 / 12 OF 13

MEMBER
 SA California Sign Association
 WSA
 ISA INTERNATIONAL SIGN ASSOCIATION

PO Box 4590 | 204 Campus Way Modesto Ca 95350 | O 209.524.4484 | F 209.521.0272 | Ca LIC#268001 | C-45 | Nv Lic#0082570 | C-6

NOTICE TO THE CUSTOMER

Note: The colors depicted on this rendering may not match actual colors used on the finished display. Please refer to the detail drawing for the approved color specifications. Note: The cost of providing electrical wiring to the sign area, all required permits and all special inspections are not included in this sign proposal. Note: The proportion of signs shown on building & landscape area photos is an approximate representation.

CUSTOMER APPROVAL

ACCEPTED W/ NO CHANGES ACCEPTED W/ CHANGES AS NOTED
 REVISE AS NOTED AND RESUBMIT


BY CUSTOMER BY LANDLORD
 DATE _____ DATE _____

COPYRIGHT
 2021

This drawing was created to assist you in visualizing our proposal. The original ideas herein are the property of Sign Designs. Permission to copy or revise this drawing can only be obtained thru a written agreement w/ Sign Designs. See your sales representative or call Sign Designs.

DATE	BY	DATE	BY	COMPANY OR JOB NAME / JOB DESCRIPTION	200337 R19
05.05.20	VT	12.23.20	VT	76 SIGN PROGRAM	
05.26.20	VT	01.12.21	VT		
06.02.20	VT	01.14.21	VT		
07.10.20	VT	01.19.21	VT		
07.28.20	VT	01.19.21	VT		
08.06.20	VT	02.18.21	VT		
08.07.20	VT	04.13.21	VT		
08.24.20	VT	04.18.21	VT		
09.03.20	VT	05.05.21	VT		
10.19.20	VT				
ADDRESS: 7337 ODAY ROAD VACAVILLE CALIFORNIA 95688				CUSTOMER CONTACT: XXXXX	
SALESPERSON: JEFF STOCKTON				NAME / DATE	12 OF 13

This sign is intended to be installed in accordance with the requirements of ARTICLE 600 of the national electrical code &/or other applicable codes. this includes proper grounding & bonding of the sign. The location of the disconnect switch after installation shall comply w/ ARTICLE 600.6(A)(1) of the National Electrical Code. All measures shown in this drawing are nominal until the "NOT FOR PRODUCTION" is removed

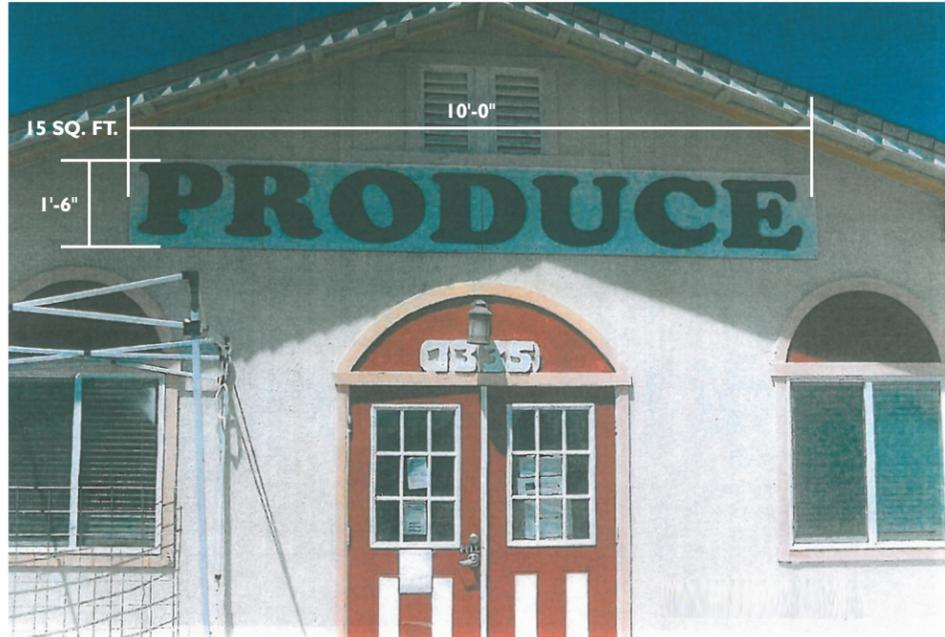

ITEMS MARKED OUT WITH RED SHALL BE REMOVED

05.05.21 R19 VT: REVERT ILLUMINATION TO GOOSENECK LAMPS FOR SIGNS A, D & K. REVERT SIGN C TO R15 VERSION. ALL PER JEFF STOCKTON. NO OTHER CHANGES. 04.18.21 R18 VT: CHANGE SIGN D TO 12X5; ADD "REMOVED BY OTHERS" TO SIGN C. CABINET PER JEFF STOCKTON. NO OTHER CHANGES. 04.13.21 R17 VT: CHANGE SIGN D TO 6X5; CABINET PER JEFF STOCKTON. NO OTHER CHANGES. 02.18.21 R16 VT: REMOVE ALL GOOSENECK LAMPS AND REVERT TO LEDS. REVERT SIGN C TO OLD MONUMENT FROM R2. ALL PER JEFF STOCKTON. NO OTHER CHANGES. 01.19.21 R15 VT: REVERT CANOPY SIGNS A PER JEFF STOCKTON. NO OTHER CHANGES. 01.19.21 R14 VT: REMOVE "X" FROM TWIN POLE SIGN ON PHOTO (PG 12) PER STEVE LOCKE. NO OTHER CHANGES. 01.14.21 R13 VT: UPDATE ADDRESS AND UPDATE SIGN L TO 7337. PER JEFF STOCKTON. NO OTHER CHANGES. 01.12.21 R12 VT: VARIOUS REDLINE CHANGES PER STEVE LOCKE, JEFF STOCKTON. ADD SIGN L (PVC ADDRESS NUMERALS). REVISE SIGN K TO "STARS" CONVENIENCE STORE PER JEFF STOCKTON/CUSTOMER. 12.23.20 R10 VT: ADD GOOSENECK LAMPS TO SIGNS A,D & K. REPLACE SIGN C WITH NEW MONUMENT SIGN. ADD VARIOUS MEASUREMENTS TO EXISTING SIGN PHOTOS ALL PER JEFF STOCKTON. NO OTHER CHANGES. 10.19.20 R10 VT: MARK POLE SIGNS ARE "REMOVED" ON PG 11 PER STEVE LOCKE. NO OTHER CHANGES. 09.03.20 R9 VT: REVISE SIGN C NEW POLE & FOOTING PER JEFF STOCKTON. NO OTHER CHANGES. 08.24.20 R1 VT: ADD PHOTOS OF EXISTING SIGNS TO BE REMOVED PER JEFF STOCKTON. NO OTHER CHANGES. 08.12.20 R7 VT: CHANGE SIGN C OAH TO 19'-6" PER JEFF STOCKTON. NO OTHER CHANGES. 08.07.20 R6 VT: ADD VARIOUS MEASUREMENTS. UPDATE SIGN C MOUNTING DETAIL. ADD STAMPED ENGINEERING PAGE. ALL PER JEFF STOCKTON. NO OTHER CHANGES. 08.06.20 R5 VT: UPDATE SITE MAP PER JEFF STOCKTON. NO OTHER CHANGES. 07.28.20 R4 VT: SIGN D-SWAP DIESEL #2 AND 24 HOURS FACES. SIGN K- SWAP COLOR SCHEME ON BACKER PANEL PER JEFF STOCKTON/CUSTOMER. NO OTHER CHANGES. 07.10.20 R3 VT: REMOVE SIGN L. CHANGE SIGN K TO "A CONVENIENCE STORE" PANS ON BACKER. ADD MOUNTING DETAILS TO SIGN D. CHANGE SIGN C LEDS TO WHITE. ALL PER JEFF STOCKTON. NO OTHER CHANGES. 06.02.20 R2 VT: PUT SIGN C ON POLE. SHOW SIGN D AS HORIZ LAYOUT AND WRONG PROPORTIONS PER JEFF STOCKTON. UPDATE PHOTO FOR SIGN K/L. ALL PER JEFF STOCKTON. NO OTHER CHANGES. 05.26.20 R1 VT: REVISE SIGN D OAH SIZE TO 8' X 5'. ADD SIGNS K & L. ALL PER JEFF STOCKTON.

200337 R19 / 13 OF 13

PERMIT DRAWING

MEMBER
SA
California Sign Association
WSA
ISA
INTERNATIONAL SIGN ASSOCIATION

PO Box 4590 | 204 Campus Way Modesto Ca 95350 | O 209.524.4484 | F 209.521.0272 | Ca LIC#268001 | C-45 | Nv Lic#0082570 | C-6

NOTICE TO THE CUSTOMER		CUSTOMER APPROVAL		DATE	BY	DATE	BY
<p>Note: The colors depicted on this rendering may not match actual colors used on the finished display. Please refer to the detail drawing for the approved color specifications. Note: The cost of providing electrical wiring to the sign area, all required permits and all special inspections are not included in this sign proposal. Note: The proportion of signs shown on building & landscape area photos is an approximate representation.</p>		<input type="checkbox"/> ACCEPTED W/ NO CHANGES <input type="checkbox"/> ACCEPTED W/ CHANGES AS NOTED <input type="checkbox"/> REVISE AS NOTED AND RESUBMIT		05.05.20	VT	12.23.20	VT
				05.26.20	VT	01.12.21	VT
				06.02.20	VT	01.14.21	VT
				07.10.20	VT	01.19.21	VT
				07.28.20	VT	01.19.21	VT
				08.06.20	VT	02.18.21	VT
				08.07.20	VT	04.13.21	VT
				08.24.20	VT	04.18.21	VT
				09.03.20	VT	05.05.21	VT
				10.19.20	VT		

COMPANY OR JOB NAME / JOB DESCRIPTION		200337 R19
76 SIGN PROGRAM		
ADDRESS: 7337 ODAY ROAD VACAVILLE CALIFORNIA 95688		
SALESPERSON: JEFF STOCKTON		
CUSTOMER CONTACT: XXXXXX		
NAME / DATE		

This sign is intended to be installed in accordance with the requirements of ARTICLE 600 of the national electrical code &/or other applicable codes. this includes proper grounding & bonding of the sign. The location of the disconnect switch after installation shall comply w/ ARTICLE 600.6(A)(1) of the National Electrical Code. All measures shown in this drawing are nominal until the "NOT FOR PRODUCTION" is removed